

JACKSON MISSISSIPPI BOARD OF WATER COMMISSIONERS

Q 185


Q 309

6-1-61


WATER WELL DRILLERS LOG

Colville

Date: 6/1, 1961, Driller: Water Supply Co. County: JACKSON  
(Name)

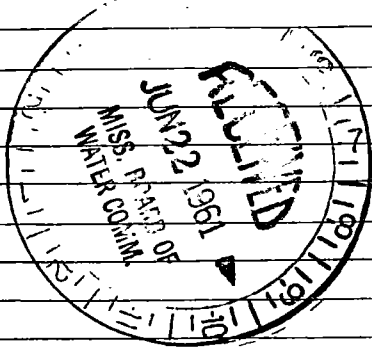	Description & Color of Materials Sand, Clay, Red Clay, Shell, etc.	Thick- ness Feet	Depth Feet
(1) Owner of Land: <u>MW Southern</u> (Name) <u>Bayou Casotte</u> (Address)			
(2) Location: <u>SW 1/4, NW 1/4, Sec 8 T8S R5W</u> <u>4</u> miles <u>SE</u> of <u>Pascagoula</u> (distance) (direction) (Nearest town)			
(3) Topography: _____ (Hilly) (Flat) (Level) <input checked="" type="checkbox"/>	Depth <u>FORM</u>	Depth <u>FORM</u>	
(4) Purpose of Well: <input checked="" type="checkbox"/> (Domestic Irrigation Municipal, Industrial, Other)	<u>0 sandy slush 10 Blue clay</u> <u>42 Sand 53 2nd</u>		
Information upon completion of well:			
(1) Diameter <u>1 1/4</u> inches.			
(2) Total Depth <u>53</u> feet.			
(3) Water Level <u>10'</u> feet below top of ground.			
(4) Cased to _____, Size _____			
(5) Screen: Size <u>1 1/4</u> , Length <u>5'</u>			
(6) Were any formations sealed against pollution? _____ yes, _____ no. <input checked="" type="checkbox"/>			
If YES depth of formation _____			
Why _____			
Drillers Remarks: _____			

Water level 10'

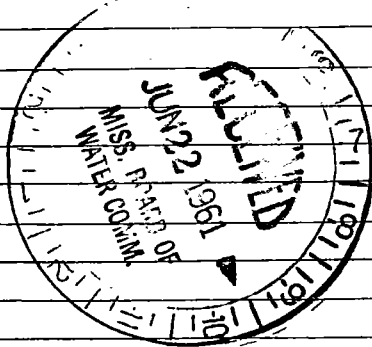

(Use Back Side)

Well No. 5

