

2

JACKSON

WATER WELL DRILLERS LOG

COLVILLE

Date: 12-27-61, 1961, Driller: Water Supply Co. County JACKSON
7-27-61 YR (Name)

(1) Owner of Land: C M Mathews (Name)

Bayou Casotte (Address)

(2) Location: NW 1/4, NW 1/4, Sec. 18 T88R5W

3 miles East of Pascagoula (distance, direction, Nearest town)

(3) Topography: (Hilly) (Flat) (Level) [checked]

(4) Purpose of Well: [checked] Domestic Irrigation, Municipal, Industrial, Other

Description & Color of Materials Sand, Clay, Red Clay, Shell, etc.	Thick- ness Feet	Depth Feet
Depth Form 0 Clay 124	118	Form SAND
124' TD		
W L 11'		

Information upon completion of well:

(1) Diameter 11 1/4 inches.

(2) Total Depth 124 feet.

(3) Water Level 11 feet below top of ground.

(4) Cased to _____, Size _____


(5) Screen: Size 1 1/4, Length 5'

(6) Were any formations sealed against pollution?
_____ yes, _____ no. [checked]

If YES depth of formation _____

Why _____

Drillers Remarks: _____

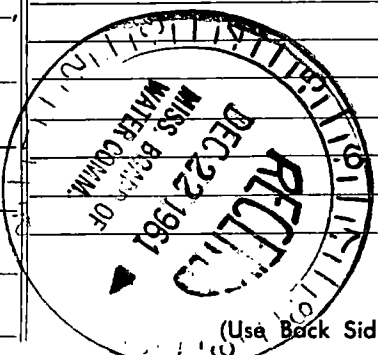

(Use Back Side)

Well No. 11

