

JACKSON MISSISSIPPI BOARD OF WATER COMMISSIONERS

Q 188

WATER WELL DRILLERS LOG


Q

8-8-66

COLVILLE

Date: 8/8, 1966, Driller: Water Supply Co County JACKSON
(Name)

(1) Owner of Land:	Description & Color of Materials Sand, Clay, Red Clay, Shell, etc.	Thick- ness Feet	Depth Feet
<u>T J Boykin</u> <small>(Name)</small> <u>Helena Miss</u> <small>(Address)</small>			
(2) Location <u>SE 1/4 NE 1/4, Sec 2 T7S R5W</u> <u>10 miles North</u> , of <u>Noss Point</u> <small>(distance) (direction) (Nearest Town)</small>			
(3) Topography: _____ <small>(Hilly) (Flat) (Level)</small> <input checked="" type="checkbox"/>	Depth <u>90M</u> Depth <u>FORM</u>		
(4) Purpose of Well: _____ <input checked="" type="checkbox"/> Domestic Irrigation Municipal, Industrial, Other	0 SAND 84 CLAY 100 yellow clay 105 SAND 178 178 CLAY 200 SAND 220 J R		
Information upon completion of well:			
(1) Diameter <u>1 1/4</u> inches.			
(2) Total Depth <u>220</u> feet.			
(3) Water Level <u>6'-9"</u> feet below top of ground.			
(4) Cased to _____, Size _____			
(5) Screen: Size <u>1 1/4</u> , Length <u>10'</u>			
(6) Were any formations sealed against pollution? _____ yes, _____ no. <input checked="" type="checkbox"/>			
If YES depth of formation _____			
Why _____			
Drillers Remarks: _____			

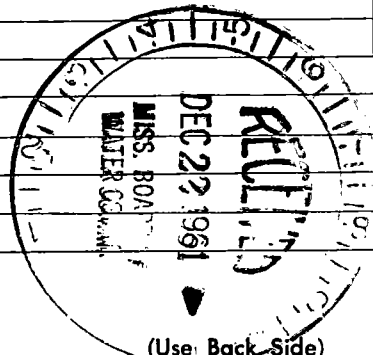

Well No. 116

