

Q 190

9-11-61

WATER WELL DRILLERS LOG

Date: Sept 11, 19 61, Driller: Colville County: Jackson  
49 (Name)

(1) Owner of Land: Andrew Branam  
(Name)  
Kv 2012  
(Address)

(2) Location: SE 1/4, SW 1/4, Sec. 33 T25R5N  
5 miles East of Boscawen  
(distance) (direction) (Nearest Town)

(3) Topography: Flat  
(Hilly) (Flat) (Level)

(4) Purpose of Well: Domestic  
(Domestic Irrigation  
Municipal, Industrial, Other)

Description & Color of Materials Sand, Clay, Red Clay, Shell, etc.	Thick- ness Feet	Depth Feet
Sand & Slush		10
Clay	32	42
Sand	47	89
Clay	16	105
Sand	40	145
Clay	2	147
Sand	74	221
Clay	9	230
Sand	22	252
		TD

Information upon completion of well:

(1) Diameter 1 1/4 inches.

(2) Total Depth 252 feet.

(3) Water Level \_\_\_\_\_ feet below top of ground.

(4) Cased to \_\_\_\_\_, Size \_\_\_\_\_.


(5) Screen: Size \_\_\_\_\_, Length \_\_\_\_\_.

(6) Were any formations sealed against pollution?  
\_\_\_\_\_ yes, \_\_\_\_\_ no.

If YES depth of formation \_\_\_\_\_

Why \_\_\_\_\_

Drillers Remarks: \_\_\_\_\_

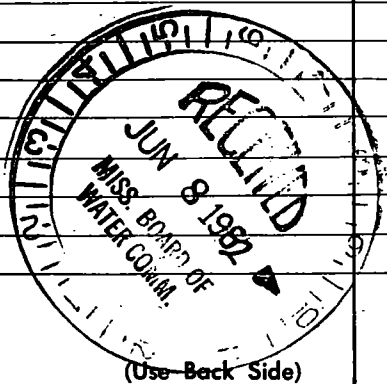

Well No. 93

