

JACKSON MISSISSIPPI BOARD OF WATER COMMISSIONERS

Q 199

WATER WELL DRILLERS LOG

5-30-62

Date: May 30, 1962, Driller: M & B Drilling Co. County: St. Jackson
 40 (Name)

(1) Owner of Land: Cecil Ryals
 (Name)
Boyer Cassette, Paragala, Miss
 (Address)

(2) Location: NW 1/4 SE 1/4, Sec. 8, T. 55N, R. 55W
1 miles East of Paragala
 (distance) (direction) (Nearest Town)

(3) Topography: Flat
 (Hilly) (Flat) (Level)

(4) Purpose of Well: Domestic
 (Domestic Irrigation
 Municipal, Industrial, Other)

Description & Color of Materials Sand, Clay, Red Clay, Shell, etc.	Thick- ness Feet	Depth Feet
<u>Clay</u>	<u>14</u>	<u>14</u>
<u>White Sand</u>	<u>3</u>	<u>17</u>
<u>Black Clay</u>	<u>102</u>	<u>120</u>
<u>Heavy coarse sand & small gravel</u>	<u>35</u>	<u>155</u>
<u>Still cutting above sand when we stopped</u>		

Information upon completion of well:

(1) Diameter 2 inches.

(2) Total Depth 150 feet.

(3) Water Level 15 feet below top of ground.

(4) Cased to 146 ft, Size 2"


(5) Screen: Size 2" x 8 1/2" length 4 ft.

(6) Were any formations sealed against pollution?
 _____ yes, _____ no.

If YES depth of formation _____

Why _____

Drillers Remarks: White sand & gravel
where well is set & water
extremely rusty.

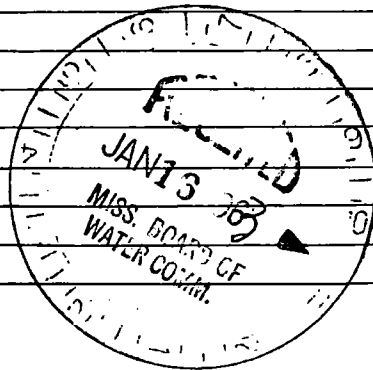

(Use Back Side)

Well No.

Handwritten notes at the top of the page, including the date "1942" and the name "John G. ...".

side note

1942

Handwritten notes at the bottom of the page, including the name "John G. ...".