

JACKSON

MISSISSIPPI BOARD OF WATER COMMISSIONERS

Q 200

WATER WELL DRILLERS LOG

6-13-62

Date: June 13, 1962, Driller: Andrew Colville County Jackson

49

(Name)

(1) Owner of Land: Henry Hulth  
(Name)  
Bayou Casotte  
(Address)

Description & Color of Materials Sand, Clay, Red Clay, Shell, etc.	Thick- ness Feet	Depth Feet
0-21 clay		
21-42 clay		
42-63 clay		
63-65 clay		
65-84 sand		
TD		

(2) Location SE 1/4, SW 1/4, Sec. 8 85 R 5N  
2 miles East of Passville  
(distance) (direction) (Nearest/Town)

(3) Topography: Flat  
(Hilly) (Flat) (Level)

(4) Purpose of Well: Industrial  
(Domestic Irrigation  
Municipal, Industrial, Other)

Information upon completion of well:

(1) Diameter 1 1/4 inches.

(2) Total Depth 84 feet.

(3) Water Level 12' feet below top of ground.

(4) Cased to \_\_\_\_\_, Size \_\_\_\_\_

(5) Screen: Size 1 1/4 Length 10'


(6) Were any formations sealed against pollution?

\_\_\_\_\_ yes, X no.

If YES depth of formation \_\_\_\_\_

Why \_\_\_\_\_

Drillers Remarks: \_\_\_\_\_

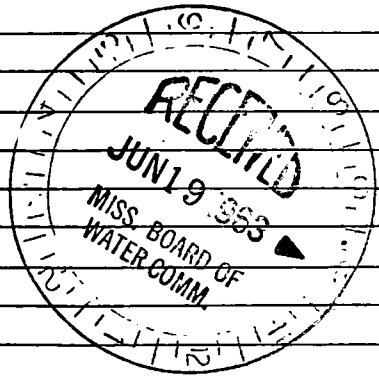

Well No. 154

(Use Back Side)

