

Q 201
6-20-62

WATER WELL DRILLERS LOG

Date: Jan 20, 1962, Driller: Andrew Colville, County: Jackson
(Name)

4 P

(1) Owner of Land: J.T. Jones
(Name)
Helena, Miss
(Address)

(2) Location: NW 1/4, NE 1/4, Sec. 6 T. 35 N. R. 5 W.
6 miles NE, of Mount
(distance) (direction) (Nearest Town)

(3) Topography: flat
(Hilly) (Flat) (Level)

(4) Purpose of Well: Domestic
(Domestic Irrigation
Municipal, Industrial, Other)

Description & Color of Materials Sand, Clay, Red Clay, Shell, etc.	Thick- ness Feet	Depth Feet
0-21 clay		
21-30 clay		
30-42 sand		
42-63 sand		
63-73 sand		
73-84 clay		
84-105 streaks s/c		
105-126 stka.		
126-144 clay		
144-147 sand		
147-149 sand		
149-168 clay		
168-180 clay		
180-189 Gritty		
189-202 clay		
202-210 sand		
210-231 sand		
231-236 sand		
TD		

Information upon completion of well:

(1) Diameter 1 1/4 inches.

(2) Total Depth 236 feet.

(3) Water Level 5'3" feet below top of ground.

(4) Cased to _____, Size _____


(5) Screen: Size 1/4, Length 10'

(6) Were any formations sealed against pollution?
_____ yes, X no.

If YES depth of formation _____

Why _____

Drillers Remarks: _____

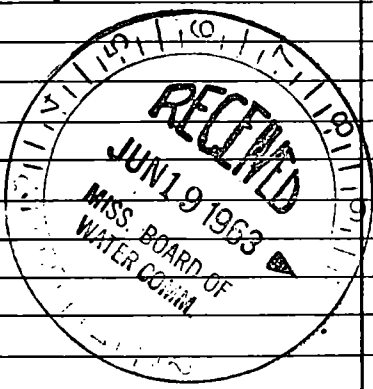

Well No.
159

(Use Back Side)

