

JACKSON MISSISSIPPI BOARD OF WATER COMMISSIONERS

Q 203

6-27-62

WATER WELL DRILLERS LOG

Date: June 27, 1962 Driller: L. L. Garland County: Jackson
(Name)

(1) Owner of Land	Description & Color of Materials Sand, Clay, Red Clay, Shell, etc.	Thick- ness Feet	Depth Feet
<u>Mr. Maples</u> <small>(Name)</small> <u>Pascagoula, Miss.</u> <small>(Address)</small>	1 10' Mud 2' Sand	9.8	Mud
(2) Location: <u>33 T 7 R 5</u> <u>3 miles East</u> of <u>Pas.</u> <small>(distance) (direction) (Nearest Town)</small>	2 Mud		
(3) Topography: <u>Dom.</u> <small>(Hilly) (Flat) (Level)</small>	3 Mud		
(4) Purpose of Well: <u>Dom.</u> <small>(Domestic Irrigation Municipal, Industrial, Other)</small>	4 Mud		
	5 Sand Strips & Mud		
	6 Mud & S. Gr.		
	7 Fine Gravel & Sand		
	8 Sand		
	10 - 6' Sand 1.5' Mud		
	11 - Mud		
	12 - "		
	13 - Sand		
	14 - 10' Sand 0.5'		

Information upon completion of well:

(1) Diameter 2 inches.

(2) Total Depth 283 feet.

(3) Water Level 63' feet below top of ground.

(4) Cased to _____, Size _____


(5) Screen: Size .08, Length 10'

(6) Were any formations sealed against pollution?
 _____ yes, _____ no.

If YES depth of formation _____

Why _____

Drillers Remarks: _____

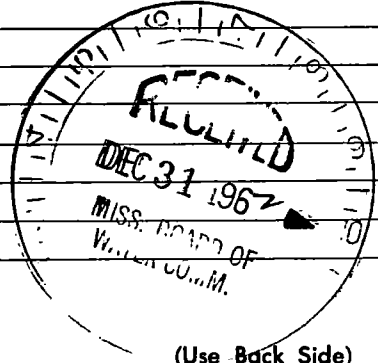

(Use Back Side)

Well No.

