

JACKSON MISSISSIPPI BOARD OF WATER COMMISSIONERS

Q 204

6-27-62

WATER WELL DRILLERS LOG


Date: June 27 1962, Driller: R. L. Harland County Jackson
(Name)

(1) Owner of Land:	Description & Color of Materials Sand, Clay, Red Clay, Shell, etc.	Thick- ness Feet	Depth Feet
(Name) <u>Mr. Maples</u> (Address) <u>Pascagoula Miss.</u>	<u>1- Mixed</u> <u>2- Mud</u> <u>3- Sand o.t.</u>		
(2) Location: $\frac{1}{4}$, $\frac{1}{4}$, Sec. <u>33 T. 7 R. 5</u> <u>3</u> miles <u>East</u> of <u>Pas.</u> <small>(distance) (direction) (Nearest Town)</small>			
(3) Topography: _____ <small>(Hilly) (Flat) (Level)</small>			
(4) Purpose of Well: <u>None</u> <small>(Domestic Irrigation Municipal, Industrial, Other)</small>			

Information upon completion of well:

- (1) Diameter 2 inches.
- (2) Total Depth 63 feet.
- (3) Water Level 11' feet below top of ground.
- (4) Cased to _____, Size _____.
- (5) Screen: Size .08, Length 10'.
- (6) Were any formations sealed against pollution?
 yes, no.

If YES depth of formation _____
 Why _____
 Drillers Remarks: _____

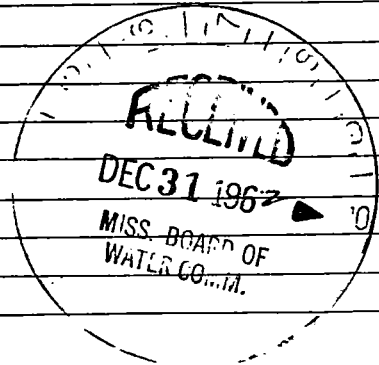

(Use Back Side)

Well No.

