

JACKSON

Q 205

WATER WELL DRILLERS LOG

8-14-62

Date: Aug 14, 1962, Driller: Flin Colville County Jackson
 59 (Name)

(1) Owner of Land: Bill Hatley
 (Name)
Melona Missin
 (Address)

(2) Location: NW 1/4, NE 1/4, Sec. 6 T5S R4W
4 miles NE, of Marion
 (distance) (direction) (Nearest Town)

(3) Topography: Flat
 (Hilly) (Flat) (Level)

(4) Purpose of Well: Domestic
 (Domestic Irrigation
 Municipal, Industrial, Other)

Description & Color of Materials Sand, Clay, Red Clay, Shell, etc.	Thick- ness Feet	Depth Feet
0-12 clay		
12-21 sand		
21-42 sandy		
42-63 sand		
63-73 sand		
73-84 clay		
84-105 clay		
105-126 clay		
126-147 clay		
147-168 clay		
168-189 clay		
189-207 streaks		
207-210 sand		
210-237 sand		
237-241 sand		
TD		

Information upon completion of well:

(1) Diameter 1 1/4 inches.

(2) Total Depth 241 feet.

(3) Water Level 7' feet below top of ground.

(4) Cased to _____, Size _____


(5) Screen: Size 1 1/4; Length 10'

(6) Were any formations sealed against pollution?
 _____ yes, X no.

If YES depth of formation _____

Why _____

Drillers Remarks: _____

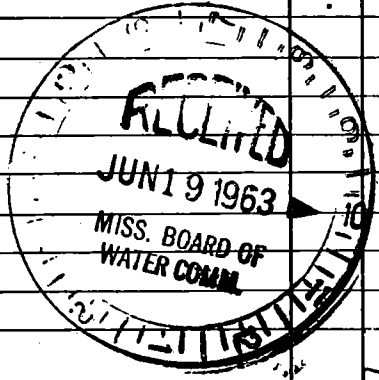

(Use Back Side)

Well No. 168

