

# JACKSON MISSISSIPPI BOARD OF WATER COMMISSIONERS

Q 206

8-15-62

## WATER WELL DRILLERS LOG

Date Aug 15, 1962, Driller: Thur Collette County Jackson  
(Name)

(1) Owner of Land: La A. Patrick  
(Name)  
Pecan Miss.  
(Address)

(2) Location: NW 1/4, NW 1/4, Sec. 18 T.7S R.14W  
6 miles East of West Point  
(distance) (direction) (Nearest Town)

(3) Topography: Flat  
(Hilly) (Flat) (Level)

(4) Purpose of Well: Domestic  
(Domestic Irrigation Municipal, Industrial, Other)

Description & Color of Materials Sand, Clay, Red Clay, Shell, etc.	Thick- ness Feet	Depth Feet
0-4 clay		
4-21 sand		
21-32 clay		
32-42 clay		
42-63 clay		
63-73 clay		
73-84 sand		
84-89 sand		
89-165 clay		
105-126 clay		
126-147 clay		
147-157 clay		
157-165 <u>hard</u> clay		
165-168 sand		
168-189 sand		
189-208 sand		
		T.D.

Information upon completion of well:

(1) Diameter 1 1/4 inches.

(2) Total Depth 208 feet.

(3) Water Level 5' feet below top of ground.

(4) Cased to \_\_\_\_\_, Size \_\_\_\_\_


(5) Screen: Size 1 1/4, Length 10'

(6) Were any formations sealed against pollution?  
 \_\_\_\_\_ yes, X no.

If YES depth of formation \_\_\_\_\_

Why \_\_\_\_\_

Drillers Remarks: \_\_\_\_\_

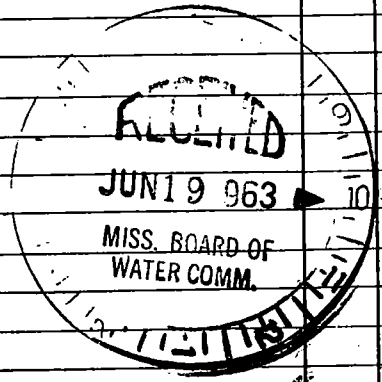

Well No. 169

(Use Back Side)

