

JACKSON MISSISSIPPI BOARD OF WATER COMMISSIONERS

Q 208

8-23-62

WATER WELL DRILLERS LOG

Jackson

Date: Aug 23, 1962, Driller: M & B Drilling Co. County Harrison

499

(Name)

(1) Owner of Land: Hugh STork  
(Name)  
Rt. 1 Pasagoala, Miss  
(Address)

(2) Location: SW 1/4, SW 1/4, Sec. 27 T25S W4  
2 miles SE, of Kreok  
(distance) (direction) (Nearest Town)

(3) Topography: Flat  
(Hilly) (Flat) (Level)

(4) Purpose of Well: Domestic  
(Domestic Irrigation  
 Municipal, Industrial, Other)

Description & Color of Materials Sand, Clay, Red Clay, Shell, etc.	Thick- ness Feet	Depth Feet
Clay	14	14
White Sand & Gravel	91	105
Blue Clay	125	230
Sand	34	264
Blue Clay	8	272
Whiteish Grey Sand	23	295
Blue clay to 412 FT on		

Information upon completion of well:

(1) Diameter 2 inches.

(2) Total Depth 293 feet.

(3) Water Level 32 feet below top of ground.

(4) Cased to 287, Size 2"


(5) Screen: Size 2" x 8 slot, Length 6 FT.

(6) Were any formations sealed against pollution?  
 \_\_\_\_\_ yes, \_\_\_\_\_ no.

If YES depth of formation \_\_\_\_\_

Why \_\_\_\_\_

Drillers Remarks: \_\_\_\_\_

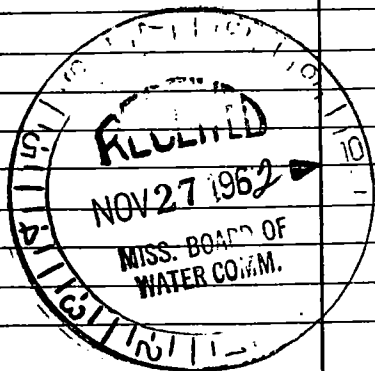

(Use Back Side)

Well No.

