

JACKSON
Q 213
11-6-62

WATER WELL DRILLERS LOG

Date: Nov 6, 1962, Driller: George Cebille County: Jackson
(Name)

4 R

(1) Owner of Land: Bolev & Easley
(Name)
Orange Grove Miss
(Address)

(2) Location: NE 1/4, SW 1/4, Sec. 23 T7SR5N
5 miles East, of Kauck
(distance) (direction) (Nearest Town)

(3) Topography: flat
(Hilly) (Flat) (Level)

(4) Purpose of Well: domestic
(Domestic Irrigation
Municipal, Industrial, Other)

Description & Color of Materials Sand, Clay, Red Clay, Shell, etc.	Thick- ness Feet	Depth Feet
7-15 yellow clay		
15-21 sand		
42-63 gravel		
63-84 clay		
84-142 gravel		
142-164 clay		
164-221 sand		
TD		

Information upon completion of well:

(1) Diameter 2 inches.

(2) Total Depth 221 feet.

(3) Water Level 23' feet below top of ground.

(4) Cased to _____, Size _____.


(5) Screen: Size 20, Length 10'.

(6) Were any formations sealed against pollution?
_____ yes, 1 no.

If YES depth of formation _____.

Why _____.

Drillers Remarks: _____

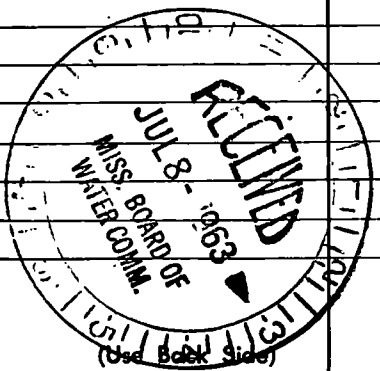

Well No. 191

