

JACKSON MISSISSIPPI BOARD OF WATER COMMISSIONERS

Q 216

1-2-63

WATER WELL DRILLERS LOG

Date: Jan 2, 1963, Driller: George Colville County Jackson

4 R

(Name)

(1) Owner of Land: Jack STORK
(Name)
PECAN, Miss.
(Address)

(2) Location: SE 1/4, NE 1/4, Sec. 18 DS RT W
5 miles East of ORANGE GROVE
(distance) (direction) (Nearest Town)

(3) Topography: Level
(Hilly) (Flat) (Level)

(4) Purpose of Well: Domestic
(Domestic Irrigation
 Municipal, Industrial, Other)

Description & Color of Materials Sand, Clay, Red Clay, Shell, etc.	Thick- ness Feet	Depth Feet
SAND	21	21
CLAY	79	100
SAND & CLAY STREAKS	5	105
CLAY	21	126
SAND	24	150
CLAY	3	153
SAND	5	158
CLAY	10	168
SAND	5	173

Information upon completion of well:

(1) Diameter 1 1/4 inches.

(2) Total Depth 173 feet.

(3) Water Level 3'-11" feet below top of ground.

(4) Cased to 163, Size 1 1/4.


(5) Screen: Size 80 62, Length 10 ft.

(6) Were any formations sealed against pollution?
 _____ yes, X no.

If YES depth of formation _____

Why _____

Drillers Remarks: _____

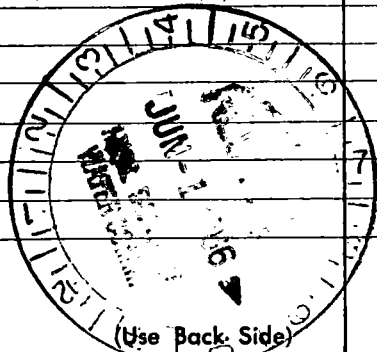

Well No. 199

