

4 R

Jackson

Q 217

2-63

MISSISSIPPI
 BOARD OF WATER COMMISSIONERS
 416 North State Street
 Jackson, Mississippi 39201

WATER WELL DRILLERS LOG

2-12

1963 Colville Water Sply Co. INC

JACKSON

date well completed

firm name

county well located

LANDOWNER: CR. STINE fellow

description of formations encountered

from

to

Prossoula, Miss.
(mailing address)

CLAY & SAND STRKS

0 22

SAND

22 66

GRAVEL

66 88

SAND

88 130

CLAY

130 132

SAND

132 148

CLAY

148 198

CLAY & SAND STREAKS

198 230

SAND

230 268

WELL LOCATION:


sec 36 T 1 N R 5 E
3 miles S of ORANGE GROVE
(distance) (direction) (nearest town)

WELL PURPOSE: HOME
(home, irrigation, municipal, industrial)

WELL COMPLETION DATA:


- (1) diameter (inches) 4
- (2) total depth (feet) 268
- (3) static water level (feet) 25 ^{below}/_{above} top of ground.
- (4) casing PPE, 248
(material) (depth)
- (size) If telescope see back.
- (5) screen 20' 248
(length) (depth to top)
- 4 BRASS W.O.P.
(size) (material)
- (6) pump 3 15
(HP) (yield gpm)
- elec.
(type power)
- (7) electric log NO
(yes or no)
- (organization running log)
- (8) how well bottom plugged B.P. valve

DRILLERS REMARKS:

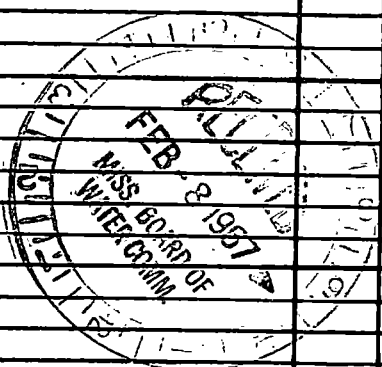

If well telescopes please sketch and show depths.

GROUND LEVEL

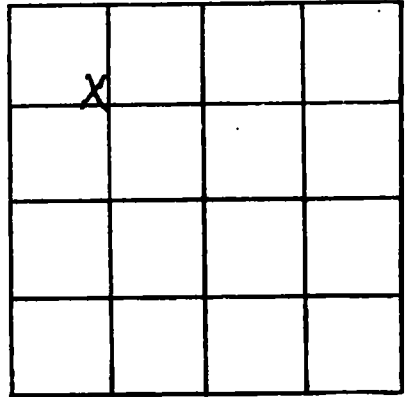

SECTION 36

Please indicate well location X.

ADDITIONAL INFORMATION

If more than one screen, show locations of each on sketch.