

4 R

| |
|---------|
| Jackson |
| Q 218 |
| 3-63 |
| |

MISSISSIPPI
 BOARD OF WATER COMMISSIONERS
 416 North State Street
 Jackson, Mississippi 39201

WATER WELL DRILLERS LOG

March 26 1963 Colville Water Supply Jackson
 date well completed firm name county well located

LANDOWNER John Glenn

Kreole, Miss.
(mailing address)


| description of formations encountered | from | to |
|---------------------------------------|------|-----|
| | CLAY | 0 |
| SAND | 10 | 13 |
| CLAY | 13 | 40 |
| SAND | 40 | 133 |
| CLAY | 133 | 180 |
| SAND | 180 | 200 |

WELL LOCATION:
 sec. 36 T. 7 N. R. 5 E.
4.5 miles E of MOOREBOND
 (distance) (direction) (nearest town)

WELL PURPOSE: Home
(home, irrigation, municipal, industrial)

WELL COMPLETION DATA:


- (1) diameter (inches) 1 1/4
- (2) total depth (feet) 200
- (3) static water level (feet) 12 below above top of ground.
- (4) casing pipe, 195
(material) (depth)
1 1/4 if telescope see back.
(size)
- (5) screen 5, 195
(length) (depth to top)
1 1/4, BRASS
(size) (material)
- (6) pump — (HP) — (yield gpm)
— (type power)
- (7) electric log No
(yes or no)
— (organization running log)
- (8) how well bottom plugged BPV & LUC

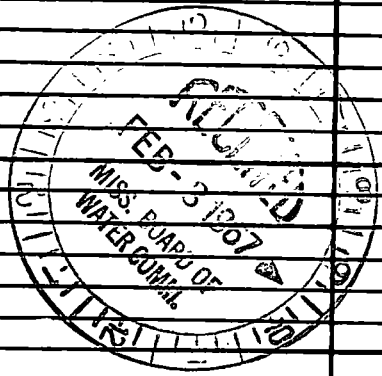

DRILLERS REMARKS:

If well telescopes please sketch and show depths.

GROUND LEVEL

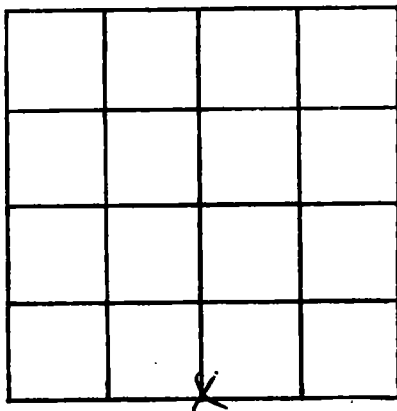

SECTION _____

Please indicate well location X.

ADDITIONAL INFORMATION

If more than one screen, show locations of each on sketch.