

JACKSON MISSISSIPPI BOARD OF WATER COMMISSIONERS

Q 219

3-13-63

WATER WELL DRILLERS LOG

Date: March 13, 1963, Driller: George Calville County Jackson
(Name)
Y R

(1) Owner of Land: Frank Laakso
(Name)

~~Laakso~~ Orange Grove
(Address)

(2) Location: NE 1/4, NW 1/4, Sec. 23 T7R4W

5 miles East, of Maple Point
(distance) (direction) (Nearest Town)

(3) Topography: Flat
(Hilly) (Flat) (Level)

(4) Purpose of Well: Domestic
(Domestic Irrigation Municipal, Industrial, Other)

| Description & Color of Materials Sand, Clay, Red Clay, Shell, etc. | Thick-ness Feet | Depth Feet |
|---|--------------------|---------------|
| Clay | | 10 |
| Sand & Gravel | 100 | 110 |
| Clay | 30 | 140 |
| Sand | 112 | 252 |
| Clay | 30 | 282 |
| Sand | 43 | 325 |


Information upon completion of well:

- (1) Diameter 1 1/4 inches.
- (2) Total Depth 325 feet.
- (3) Water Level 12 feet below top of ground.
- (4) Cased to _____, Size _____.
- (5) Screen: Size 1 1/4, Length 10'.
- (6) Were any formations sealed against pollution?
 _____ yes, no.

If YES depth of formation _____

Why _____

Drillers Remarks: _____

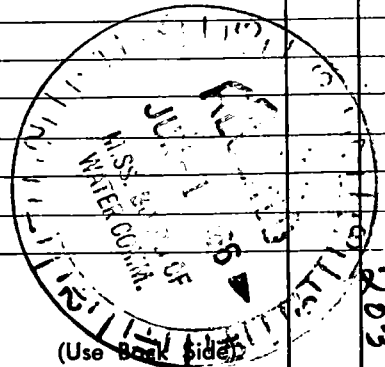

(Use back side)

