

**JACKSON** MISSISSIPPI BOARD OF WATER COMMISSIONERS

Q 220

3-25-63

**WATER WELL DRILLERS LOG**

Date: March 25 1963, Driller: George Colville County: Jackson  
(Name)  
 59


(1) Owner of Land: Gary Smith  
(Name)  
Fscatampa Miss  
(Address)  
 (2) Location: SW 1/4, SW 1/4, Sec. 6 T. 12 R. 5 W. 7  
5 miles NE of MP  
(distance) (direction) (Nearest Town)  
 (3) Topography: Flat  
(Hilly) (Flat) (Level)  
 (4) Purpose of Well: Domestic  
(Domestic Irrigation Municipal, Industrial, Other)

Description & Color of Materials Sand, Clay, Red Clay, Shell, etc.	Thick-ness Feet	Depth Feet
Clay		10
Sandy Clay & Gravelly	106	116
Clay	20	136
Sand	84	220
Clay	83	303
Sand	9	312

Information upon completion of well:

(1) Diameter 1 1/4 inches.  
 (2) Total Depth 312 feet.  
 (3) Water Level 20 feet below top of ground.  
 (4) Cased to \_\_\_\_\_, Size \_\_\_\_\_  
 (5) Screen: Size 1/4, Length 10'  
 (6) Were any formations sealed against pollution?  
 \_\_\_\_\_ yes,  no.

If YES depth of formation \_\_\_\_\_  
 Why \_\_\_\_\_  
 Drillers Remarks: \_\_\_\_\_

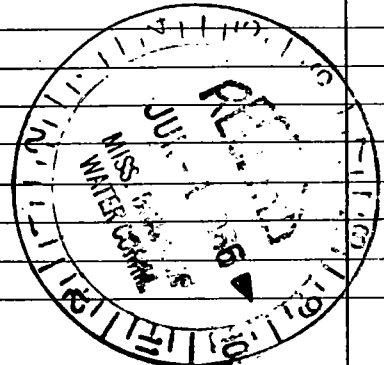

(Use Back Side)

Well No. 005

