

49

Jackson
Q 222
4-63

**MISSISSIPPI
BOARD OF WATER COMMISSIONERS**
416 North State Street
Jackson, Mississippi 39201

WATER WELL DRILLERS LOG

April 20 1963 Colville Water Supply Co. Inc Jackson
 date well completed firm name county well located

LANDOWNER: J. D. Stewart

Helena, Missi
(mailing address)

WELL LOCATION:
 sec. 3 T 7 N 5 R 5 E
12 miles NE of Miss Point
 (distance) (direction) (nearest town)

description of formations encountered	from	to
Clay	0	16
Sand & Gravelly ss	16	100
Clay	100	140
Sand	140	143
Clay	143	180
Sand	180	189
Clay	189	189
Sand	189	209

WELL PURPOSE: Home
 (home, irrigation, municipal, industrial)

WELL COMPLETION DATA:

(1) diameter (inches) 1 1/4

(2) total depth (feet) 209

(3) static water level (feet) 11 below above top of ground.

(4) casing _____ (material), _____ (depth), _____ (size) If telescope see back.

(5) screen 5' 204 (length) (depth to top)
1 1/4 Brass (size) (material)

(6) pump 1/2 5 (HP) (yield gpm)

Elec (type power)

(7) electric log No (yes or no)
 _____ (organization running log)

(8) how well bottom plugged BP Valley


DRILLERS REMARKS:



If well telescopes please sketch and show depths.

GROUND LEVEL

SW NW

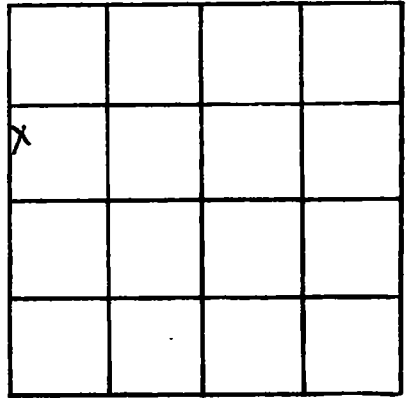

SECTION 3

Please indicate well location X.

ADDITIONAL INFORMATION

If more than one screen, show locations of each on sketch.