

49

| |
|---------|
| Jackson |
| 9223 |
| 5-63 |

MISSISSIPPI
 BOARD OF WATER COMMISSIONERS
 416 North State Street
 Jackson, Mississippi 39201

WATER WELL DRILLERS LOG

May 27 19 63 Polville Water Supply Co Jackson
 date well completed firm name county well located

LANDOWNER: Jack Delmas

Pascagoula Miss.
(mailing address)

WELL LOCATION:

sec. 17 T. 2 N R. 5 E
 2 miles East of Asc.
 (distance) (direction) (nearest town)

WELL PURPOSE: home
 (home, irrigation, municipal, industrial)

WELL COMPLETION DATA:

- (1) diameter (inches) 4 X 2
- (2) total depth (feet) 294
- (3) static water level (feet) 96 1/2 ^{below} _{above} top of ground.
- (4) casing Steel, 171'-10"
 (material) (depth)
 (size) if telescope see back. 2.84
- (5) screen 10" ^{Stainless}
 (length) (depth to top)
 2" ^{Stainless}
 (size) (material)
- (6) pump 1 15
 (HP) (yield gpm)
 also
 (type power)
- (7) electric log No
 (yes or no)
 (organization running log)
- (8) how well bottom plugged

description of formations encountered

from to

| | | |
|-------|-----|-----|
| Slush | 0 | 15 |
| Clay | 15 | 52 |
| Sand | 52 | 56 |
| Clay | 56 | 126 |
| Sand | 126 | 210 |
| Clay | 210 | 258 |
| sand | 258 | 294 |


DRILLERS REMARKS:



If well telescopes please sketch and show depths.

GROUND LEVEL

NE NW

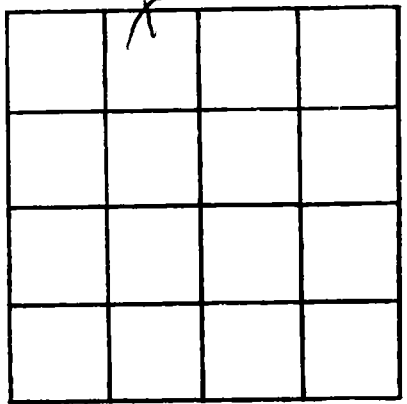

SECTION 17

Please indicate well location X.

ADDITIONAL INFORMATION

If more than one screen, show locations of each on sketch.