

# JACKSON MISSISSIPPI BOARD OF WATER COMMISSIONERS

Q 224

5-7-63

## WATER WELL DRILLERS LOG

Date: May 7, 1963, Driller: George W. Colville County Jackson  
(Name)

(1) Owner of Land: Claude Blanchard  
(Name)  
P.O. Box 3494  
Pascagoula, Miss.  
(Address)

(2) Location: NW 1/4, NW 1/4, Sec. 36, T. 7 S. R. 5 E.  
3 miles South of Orang Grove  
(distance) (direction) (Nearest Town)

(3) Topography: Flat  
(Hilly) (Flat) (Level)

(4) Purpose of Well: Domestic  
(Domestic Irrigation  
Municipal, Industrial, Other)

Description & Color of Materials Sand, Clay, Red Clay, Shell, etc.	Thick- ness Feet	Depth Feet
<u>Sandy Clay</u>	<u>22</u>	<u>22</u>
<u>sand</u>	<u>42</u>	<u>64</u>
<u>Clay</u>	<u>2</u>	<u>66</u>
<u>Sand with clay streaks</u>	<u>22</u>	<u>88</u>
<u>Clay</u>	<u>4</u>	<u>92</u>
<u>Sand &amp; Gravel</u>	<u>62</u>	<u>154</u>
<u>Clay</u>	<u>46</u>	<u>210</u>
<u>Sand</u>	<u>53</u>	<u>263</u>

### Information upon completion of well:

(1) Diameter: 2 x 1 1/2 inches.

(2) Total Depth: 263 feet.

(3) Water Level: 29'-8" feet below top of ground.

(4) Cased to 253, Size 169-1 1/4  
84-2


(5) Screen: Size 80ga, Length 10 ft.

(6) Were any formations sealed against pollution?  
 yes,  no.

If YES depth of formation \_\_\_\_\_

Why \_\_\_\_\_

Drillers Remarks: \_\_\_\_\_

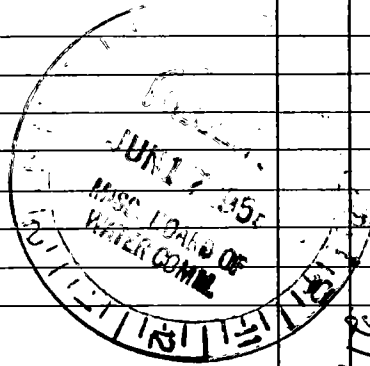

Well No. 917

(Use Back Side)

