

Jackson

MISSISSIPPI BOARD OF WATER COMMISSIONERS

Q 225

4-63

WATER WELL DRILLERS LOG

Date: APR 19, 1963, Driller: George Colville County Jackson
(Name)
49

(1) Owner of Land: Blue Lake Manor
(Name)
Paccagonla Miss
(Address)

(2) Location: NE 1/4, SE 1/4, Sec. 6 T8S R5W
(distance) (direction) (Nearest Town)

(3) Topography: Flat
(Hilly) (Flat) (Level)

(4) Purpose of Well: Test Hole
(Domestic Irrigation
Municipal, Industrial, Other)

Description & Color of Materials Sand, Clay, Red Clay, Shell, etc.	Thick- ness Feet	Depth Feet
		22
Clay		22
Sand	18	40
Clay	4	44
Sand	34	78
Clay	10	88
Sand	117	205
Clay	49	254
Sand (Grey)	54	308

Information upon completion of well:

(1) Diameter ~~4 1/2~~ 8 inches.

(2) Total Depth 303 feet.

(3) Water Level 61'-9" feet below top of ground.


(4) Cased to 286, Size 8in

(5) Screen: Size .008, Length 20

(6) Were any formations sealed against pollution?
 yes, no.

If YES depth of formation 286
Why Required By Contract

Drillers Remarks: 2 wells
about 100 yds
apart - same construction

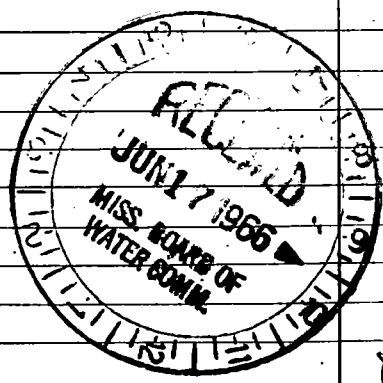

Well No.
Q18
213

(Use Back Side)

