

4 R

Jackson
Q 226
6-63

MISSISSIPPI  
BOARD OF WATER COMMISSIONERS  
416 North State Street  
Jackson, Mississippi 39201

WATER WELL DRILLERS LOG

June 23 1963 Colville Water Supply Jackson  
date well completed firm name county well located

LANDOWNER: F. T. Boykin

description of formations encountered	from	to
Clay	0	21
Sand	21	50
Clay	50	126
Sand	126	178
Clay	178	204
Sand	204	260
Clay	260	546
Sand	546	577


Helena Miss  
(mailing address)

WELL LOCATION:  
sec 2 T 7 N R 5 E  
(distance) 12 miles East of Mountain Point  
(direction) (nearest town)

WELL PURPOSE: Drone  
(home, irrigation, municipal, industrial)

- WELL COMPLETION DATA:
- (1) diameter (inches) 1 1/4
  - (2) total depth (feet) 576
  - (3) static water level (feet) 8'6" below above top of ground.
  - (4) casing \_\_\_\_\_ (material), \_\_\_\_\_ (depth)  
\_\_\_\_\_ (size) if telescope see back.
  - (5) screen 17' 566  
(length) (depth to top)  
1 1/4 brass  
(size) (material)
  - (6) pump \_\_\_\_\_ (HP) \_\_\_\_\_ (yield gpm)  
\_\_\_\_\_ (type power)
  - (7) electric log no  
(yes or no)  
\_\_\_\_\_ (organization running log)
  - (8) how well bottom plugged B.P. Valve


DRILLERS REMARKS:

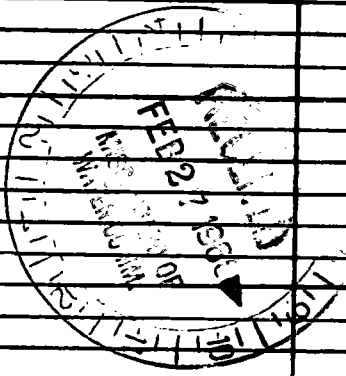

If well telescopes please sketch and show depths.

GROUND LEVEL

NE SW

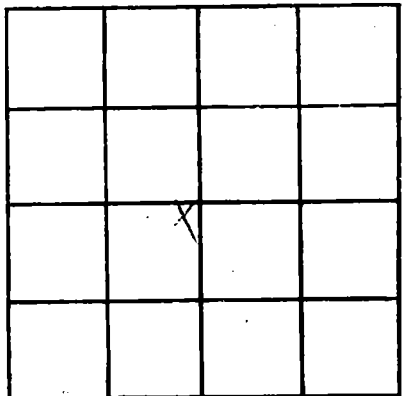

SECTION 2

Please indicate well location X.

ADDITIONAL INFORMATION

If more than one screen, show locations of each on sketch.