

49

*Jackson*  
 Q 227  
 7-63

MISSISSIPPI  
 BOARD OF WATER COMMISSIONERS  
 416 North State Street  
 Jackson, Mississippi 39201

WATER WELL DRILLERS LOG

*July 10* 19 *63* *Colville Water Supply* *Jackson*  
 date well completed firm name county well located

LANDOWNER: *Burroughs*  
*Trailer Park*  
*Pascagoula Miss*  
 (mailing address)

description of formations encountered	from	to
<i>Sand</i>	<i>0</i>	<i>15</i>
<i>Clay</i>	<i>15</i>	<i>35</i>
<i>Sand</i>	<i>35</i>	<i>225</i>
<i>Clay</i>	<i>225</i>	<i>305</i>
<i>Sand</i>	<i>305</i>	<i>342</i>

WELL LOCATION:  
 sec. *18* T *5* N R *5* E  
*Pascagoula*  
 (distance) miles (direction) of (nearest town)

WELL PURPOSE: *Trailer Park*  
 (home, irrigation, municipal, industrial)

WELL COMPLETION DATA:

(1) diameter (inches) *4"*

(2) total depth (feet) *342-6"*

(3) static water level (feet) *736* (below/above top of ground)

(4) casing (material) (depth)  
 (size) if telescope see back.

(5) screen *10"* *332*  
 (length) (depth to top)  
*2"* *Brass*  
 (size) (material)

(6) pump *2* *28*  
 (HP) (yield gpm)  
*elec*  
 (type power)

(7) electric log *no*  
 (yes or no)  
 (organization running log)

(8) how well bottom plugged *BP Valve*


DRILLERS REMARKS:



If well telescopes please sketch and show depths.

GROUND LEVEL

SW NW

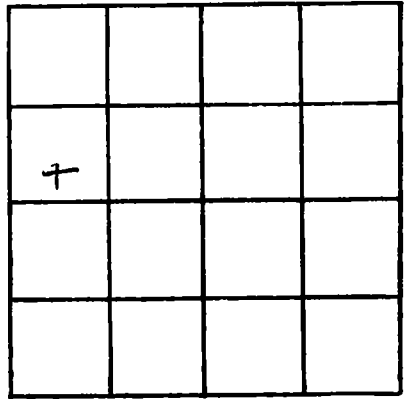

SECTION 18

Please indicate well location X.

ADDITIONAL INFORMATION

If more than one screen, show locations of each on sketch.