

49

Jackson
Q 228
7-63

MISSISSIPPI
BOARD OF WATER COMMISSIONERS
416 North State Street
Jackson, Mississippi 39201

WATER WELL DRILLERS LOG

July 13 1963 date well completed
Cobalt Water Supply firm name
Jackson county well located

LANDOWNER: Louis Peloso

description of formations encountered

from to

Moss Point
Mississippi
(mailing address)

Shale 0 60
Sand 60 73

WELL LOCATION:

sec 30 T 7 N R 50 E
Moss Point
miles of (distance) (direction) of (nearest town)

WELL PURPOSE: Irrigation
(home, irrigation, municipal, industrial)

WELL COMPLETION DATA:

(1) diameter (inches) 1 1/4
(2) total depth (feet) 73
(3) static water level (feet) 12 below above top of ground.

(4) casing (material) (depth)
(size) If telescope see back.

(5) screen 5 72
(length) (depth to top)
1/4 (size) brass (material)


(6) pump (HP) (yield gpm)
(type power)

(7) electric log no
(yes or no)

(organization running log)


(8) how well bottom plugged B.P. done

DRILLERS REMARKS:

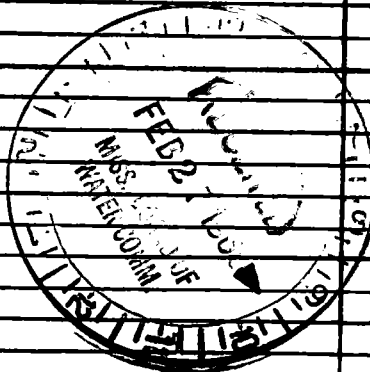

If well telescopes please sketch and show depths.

GROUND LEVEL

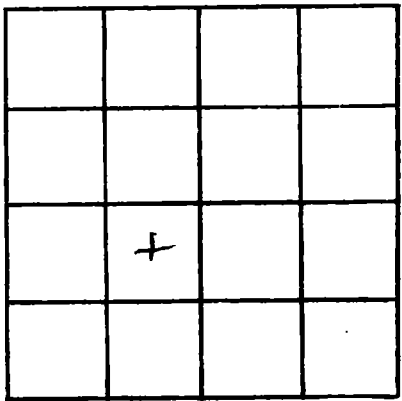

SECTION 30

Please indicate well location X.

ADDITIONAL INFORMATION

If more than one screen, show locations of each on sketch.