

4 R

Jackson
Q 229
7-63

MISSISSIPPI  
 BOARD OF WATER COMMISSIONERS  
 416 North State Street  
 Jackson, Mississippi 39201

WATER WELL DRILLERS LOG

July 26 19 63 Calville Water Supply Jackson  
 date well completed firm name county well located

LANDOWNER: J. D. Alexander

description of formations encountered

from

to

Pecan Mine  
 (mailing address)

Sand  
Sand

0

54

WELL LOCATION:


sec. 6 T. 7 N. R. 5 E.  
 ③ ④  
8 miles east of Pascagoula  
 (distance) (direction) (nearest town)

WELL PURPOSE: home  
 (home, irrigation, municipal, industrial)

WELL COMPLETION DATA:


- (1) diameter (inches) 1 1/4
- (2) total depth (feet) 54
- (3) static water level (feet) 6 <sup>below</sup> <sub>above</sub> top of ground.
- (4) casing \_\_\_\_\_ (material), \_\_\_\_\_ (depth),  
 \_\_\_\_\_ (size) if telescope see back.
- (5) screen 5 \_\_\_\_\_ 41  
 (length) (depth to top)  
1 1/4 \_\_\_\_\_ brass  
 (size) (material)
- (6) pump \_\_\_\_\_ (HP) \_\_\_\_\_ (yield gpm)  
 \_\_\_\_\_ (type power)
- (7) electric log no (yes or no)  
 \_\_\_\_\_ (organization running log)
- (8) how well bottom plugged BPJahel

DRILLERS REMARKS:

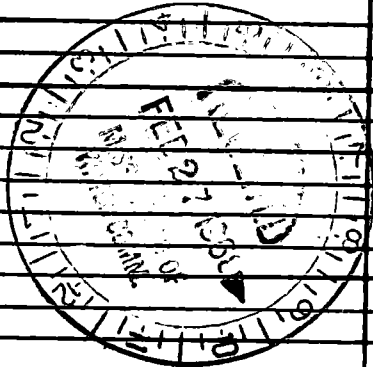

If well telescopes please sketch and show depths.

GROUND LEVEL

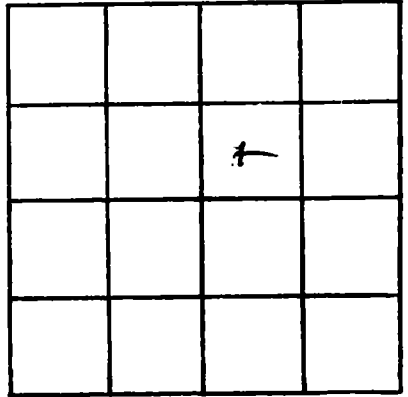

SECTION 6

Please indicate well location X.

ADDITIONAL INFORMATION

Lined area for additional information.

If more than one screen, show locations of each on sketch.