

4 R

Jackson
Q 230
7-63

MISSISSIPPI
 BOARD OF WATER COMMISSIONERS
 416 North State Street
 Jackson, Mississippi 39201

WATER WELL DRILLERS LOG

July 25 1963 date well completed
 Pelville Water Supply firm name
 Jackson county well located

LANDOWNER: Sam Braden

description of formations encountered	from	to
Clay	6	21
sand	21	36
clay	36	63
sand	63	74
clay	74	120
sand	120	131

Deppan Miss (mailing address)

WELL LOCATION:
 sec. 7 T. 7 N. R. 4 E.
 6 miles east of MP
 (distance) (direction) (nearest town)

WELL PURPOSE: home (home, irrigation, municipal, industrial)

WELL COMPLETION DATA:

- (1) diameter (inches) 1 1/4
- (2) total depth (feet) 131
- (3) static water level (feet) 5' below top of ground.
- (4) casing (material) (depth) (size) If telescope see back.
- (5) screen 5' (length) 126 (depth to top) 1 1/4 (size) brass (material)
- (6) pump (HP) (yield gpm) (type power)
- (7) electric log no (yes or no)

(organization running log)


(8) how well bottom plugged B.P. Weber

DRILLERS REMARKS:

If well telescopes please sketch and show depths.

GROUND LEVEL

SW SE

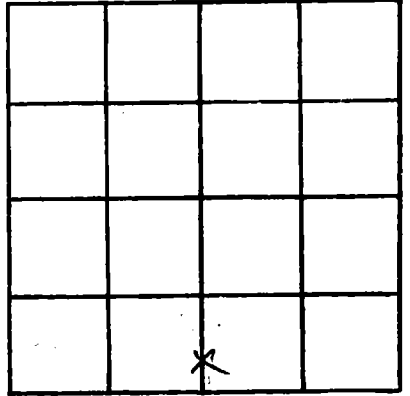

SECTION 7

Please indicate well location X.

ADDITIONAL INFORMATION



If more than one screen, show locations of each on sketch.