

4 R

| |
|---------|
| Jackson |
| Q 231 |
| 7-63 |
| |

MISSISSIPPI
 BOARD OF WATER COMMISSIONERS
 416 North State Street
 Jackson, Mississippi 39201

WATER WELL DRILLERS LOG

July 8 1963 Palmer Water Supply Jackson
 date well completed firm name county well located

LANDOWNER: Sam Bowden

description of formations encountered

from

to

Recam Main
(mailing address)

| | | |
|------|-----|-----|
| Clay | 0 | 21 |
| Sand | 21 | 56 |
| Clay | 56 | 120 |
| Sand | 120 | 136 |


WELL LOCATION:

sec 7 T 7 N R 4 E
6 miles east of Mad.
 (distance) (direction) (nearest town)

WELL PURPOSE: home
(home, irrigation, municipal, industrial)

WELL COMPLETION DATA:


- (1) diameter (inches) 1 1/4
- (2) total depth (feet) 136
- (3) static water level (feet) 13-6 " below above top of ground.
- (4) casing (material) (depth)
 (size) If telescope see back.
- (5) screen 5' 131
 (length) (depth to top)
1 1/4 brass
 (size) (material)
- (6) pump (HP) (yield gpm)
 (type power)
- (7) electric log no
 (yes or no)
 (organization running log)
- (8) how well bottom plugged B.P. Wax

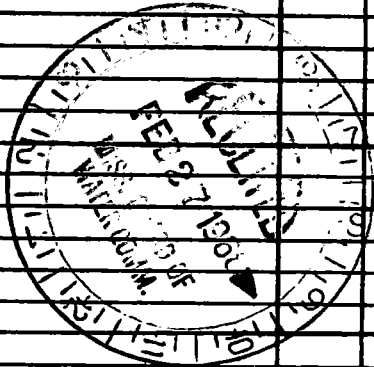

DRILLERS REMARKS:

If well telescopes please sketch and show depths.

GROUND LEVEL

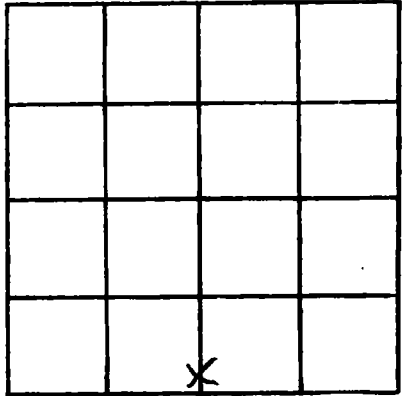

SECTION 7

Please indicate well location X.

ADDITIONAL INFORMATION

If more than one screen, show locations of each on sketch.