

Q 232

8-63

WATER WELL DRILLERS LOG

Date: Aug 1, 1963, Driller: George Colville County Jackson
Colville Water Supply

(1) Owner of Land: Blue Lake Manor
(Name)
Pascagoula, Miss.
(Address)

(2) Location: SE 1/4, SW 1/4, Sec. 6 T8R5W
1/2 miles E of Pascagoula
(distance) (direction) (Nearest Town)

(3) Topography: FLAT
(Hilly) (Flat) (Level)

(4) Purpose of Well: Dom
(Domestic Irrigation
Municipal, Industrial, Other)

Description & Color of Materials Sand, Clay, Red Clay, Shell, etc.	Thick- ness Feet	Depth Feet
CLAY	10	10
SAND	70	80
CLAY	30	110
SAND	100	210
CLAY	63	273
SAND	23	296

Information upon completion of well:

(1) Diameter 8 inches.

(2) Total Depth 296 feet.

(3) Water Level -66 feet below top of ground.

(4) Cased to 276, Size 8 in.


(5) Screen: Size .008, Length 20 ft.

(6) Were any formations sealed against pollution?
 yes, no.

If YES depth of formation 276

Why Required By Contract

Drillers Remarks: Casing completely cemented in.

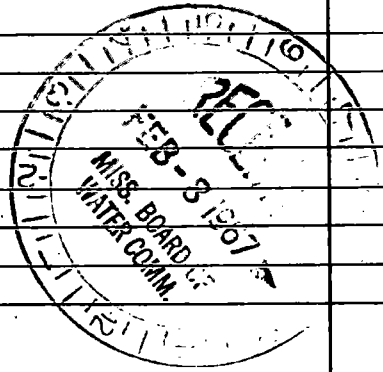

Well No. 176

(Use Back Side)

