

Jackson
 Q235
 9-63

MISSISSIPPI
 BOARD OF WATER COMMISSIONERS
 416 North State Street
 Jackson, Mississippi 39201

WATER WELL DRILLERS LOG

Sept 6 1963 date well completed
 Atchafalpa Water Supply firm name
 Jackson county well located

LANDOWNER: Don Roberts

description of formations encountered	from	to
Clay	0	21
Sand	21	78
Clay	78	89
Sand	89	144
Clay	144	199
Gravel	199	225

Bayou Coumbert Min
 (mailing address)

WELL LOCATION:
 sec. 36 T. 7 N. R. 5 E.
 (S) (W)
3 1/2 miles S of Orange Grove
 (distance) (direction) (nearest town)

WELL PURPOSE: Home
 (home, irrigation, municipal, industrial)

WELL COMPLETION DATA:

- (1) diameter (inches) 2
- (2) total depth (feet) 225
- (3) static water level (feet) 25 ^{below} ~~above~~ top of ground.
- (4) casing _____ (material), _____ (depth), _____ (size) if telescope see back.
- (5) screen 5 _____ (length), 220 _____ (depth to top), 1 1/4 _____ (size), Stainless _____ (material)
- (6) pump _____ (HP), _____ (yield gpm), _____ (type power)
- (7) electric log no (yes or no), _____ (organization running log)
- (8) how well bottom plugged BP Valve


DRILLERS REMARKS:



If well telescopes please
sketch and show depths.

GROUND LEVEL

MW NW

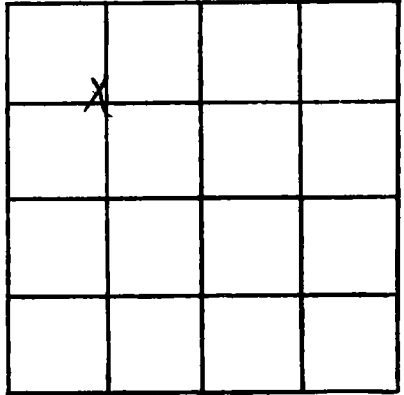

SECTION 36

Please indicate well location X.

ADDITIONAL INFORMATION

If more than one screen,
show locations of each on sketch.