

Jackson  
 Q 236  
 10-63

MISSISSIPPI  
 BOARD OF WATER COMMISSIONERS  
 416 North State Street  
 Jackson, Mississippi 39201

WATER WELL DRILLERS LOG

Oct 4 1963 Colville Water Supply Jackson  
 date well completed firm name county well located

LANDOWNER: Willie Baker

description of formations encountered	from	to
clay	0	8
sand	8	30
shells & clay	30	42
sand	42	84
clay	84	130
sand	130	147
Clay	147	167
Sand	167	225
clay	225	383
Sand	383	399

Pearl Mine  
 (mailing address)


WELL LOCATION:  
 sec. 12 T. 7 N. R. 5 E.  
5 miles east of Passport  
 (distance) (direction) (nearest town)

WELL PURPOSE: home  
 (home, irrigation, municipal, industrial)

WELL COMPLETION DATA:


- (1) diameter (inches) 2"
- (2) total depth (feet) 399
- (3) static water level (feet) 6 below above top of ground.
- (4) casing (material) (depth) (size) if telescope see back.
- (5) screen 15' 384 (length) (depth to top)  
2" Stainless Steel (size) (material)
- (6) pump (HP) (yield gpm) (type power)
- (7) electric log no (yes or no) (organization running log)
- (8) how well bottom plugged B.P. Valley

DRILLERS REMARKS:

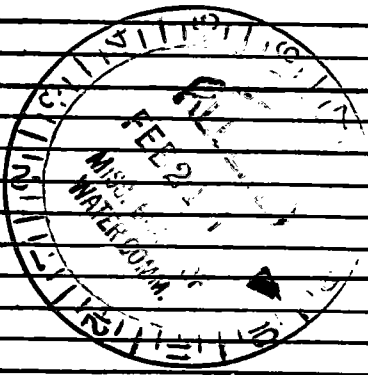

If well telescopes please sketch and show depths.

GROUND LEVEL

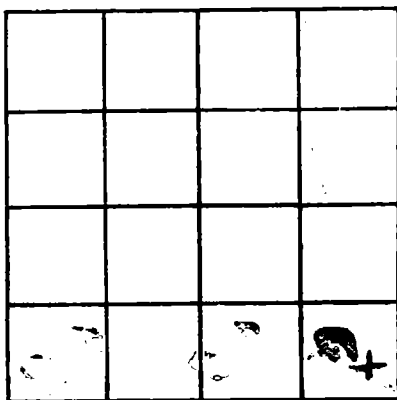

SECTION 12

Please indicate well location X.

ADDITIONAL INFORMATION

If more than one screen, show locations of each on sketch.