

49

MISSISSIPPI
BOARD OF WATER COMMISSIONERS
416 North State Street
Jackson, Mississippi 39201

WATER WELL DRILLERS LOG

Oct 23 1963 Cubille water supply Jackson
date well completed firm name county well located

LANDOWNER: Q. R. Stephens

description of formations encountered

from

to

Brook, Miss.
(mailing address)

WELL LOCATION:


sec. 27 T 7 N R 5 E
8 miles S of Brook Point
(distance) (direction) (nearest town)

WELL PURPOSE: home
(home, irrigation, municipal, industrial)

WELL COMPLETION DATA:


- (1) diameter (inches) 1 1/4
- (2) total depth (feet) 113
- (3) static water level (feet) 12 below
top of ground. above
- (4) casing _____
(material) (depth)
(size) if telescope see back.
- (5) screen 5' 113
(length) (depth to top)
1/4 brass
(size) (material)
- (6) pump _____
(HP) (yield gpm)
(type power)
- (7) electric log no
(yes or no)
(organization running log)
- (8) how well bottom plugged B.P. Chiles

DRILLERS REMARKS:

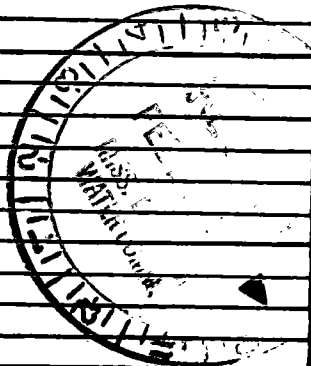

If well telescopes please
sketch and show depths.

GROUND LEVEL

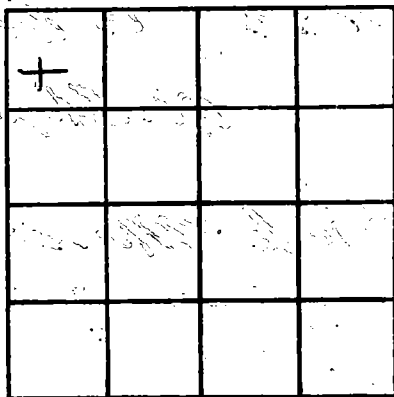

SECTION 29

Please indicate well location X.

ADDITIONAL INFORMATION

If more than one screen,
show locations of each on sketch.