

49

Jackson
Q239
1-64

MISSISSIPPI
 BOARD OF WATER COMMISSIONERS
 416 North State Street
 Jackson, Mississippi 39201

WATER WELL DRILLERS LOG

Jan 14, 64 date well completed Colville Water Supply firm name Jackson county well located

LANDOWNER: Standard Contracting Services
Passapatanz (mailing/address)


description of formations encountered	from	to
slush	0	10
clay	10	40
sand	40	50

WELL LOCATION:
 sec. 32 T. 7 N R. 5 E
3 miles east of Passapatanz
 (distance) (direction) (nearest town)

WELL PURPOSE: ind.
 (home, irrigation, municipal, industrial)

WELL COMPLETION DATA:

- (1) diameter (inches) 1 1/4
- (2) total depth (feet) 50
- (3) static water level (feet) 15 below above top of ground.
- (4) casing _____ (material), _____ (depth), _____ (size) if telescope see back.
- (5) screen 5 45 (length) (depth to top)
1 1/4 plastic (size) (material)
- (6) pump _____ (HP) _____ (yield gpm)
 _____ (type power)
- (7) electric log no (yes or no)
 _____ (organization running log)
- (8) how well bottom plugged B.P. value

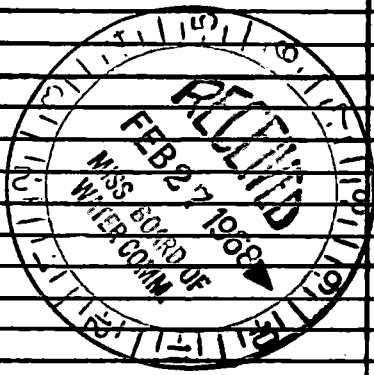


DRILLERS REMARKS:

If well telescopes please sketch and show depths.

NE NW

GROUND LEVEL

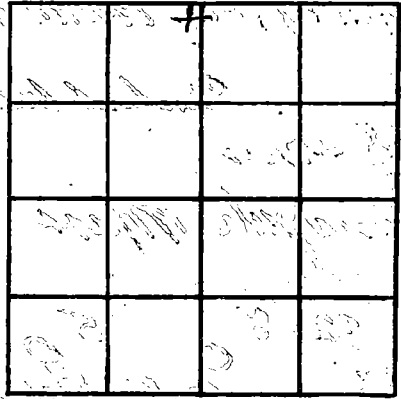

SECTION 32

Please indicate well location X:

ADDITIONAL INFORMATION

A series of horizontal lines for writing additional information, starting below the 'ADDITIONAL INFORMATION' header.

If more than one screen, show locations of each on sketch.