

4 R

MISSISSIPPI
 BOARD OF WATER COMMISSIONERS
 416 North State Street
 Jackson, Mississippi 39201

WATER WELL DRILLERS LOG

Jackson
 Q 240
 1-64

Jan 7 1964 Abville Water Supply Jackson
 date well completed firm name county well located

LANDOWNER: Cecil Betty

Helena Minn
 (mailing address)


WELL LOCATION:
 sec. 2 T-7 N R-5 E
11 miles NE of Maple Point
 (distance) (direction) (nearest town)

WELL PURPOSE: Home
 (home, irrigation, municipal, industrial)

WELL COMPLETION DATA:

- (1) diameter (inches) 2
- (2) total depth (feet) 735
- (3) static water level (feet) 16 below top of ground.
- (4) casing _____ (material), _____ (depth), _____ (size) if telescope see back.
- (5) screen 10 _____, 725 _____ (length) (depth to top)
2 _____, Brass Slot _____ (size) (material)
- (6) pump _____ (HP) _____ (yield gpm)
 _____ (type power)
- (7) electric log no _____ (yes or no)
 _____ (organization running log)
- (8) how well bottom plugged BPVdy

description of formations encountered	from	to
clay	0	10
sand	10	89
clay	89	117
sand	117	168
clay	168	713
sand	713	735

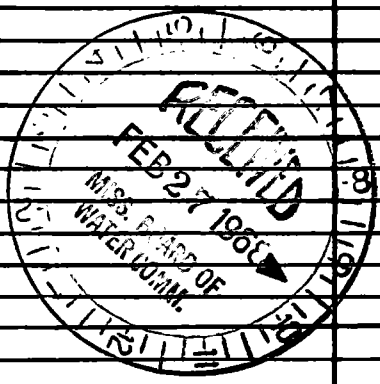

DRILLERS REMARKS:

If well telescopes please sketch and show depths.

GROUND LEVEL

	X		

SECTION 2

Please indicate well location X.

ADDITIONAL INFORMATION

If more than one screen, show locations of each on sketch.