

4 R

MISSISSIPPI
 BOARD OF WATER COMMISSIONERS
 416 North State Street
 Jackson, Mississippi 39201

WATER WELL DRILLERS LOG

Jackson
 241
 2-64

Feb 29 1964 Colville Water Supply Jackson
 date well completed firm name county well located

LANDOWNER: Bosarge
and Ellis
Orange Grove Mine
 (mailing address)

description of formations encountered	from to	
	feet	feet
clay	0	18
sand	18	147
clay	147	170
sand	170	236


WELL LOCATION:
 sec. 23 T. 7 N R. 5 E
8 miles east of Sharpsburg
 (distance) (direction) (nearest town)

WELL PURPOSE: Home and health use
 (home, irrigation, municipal, industrial)

WELL COMPLETION DATA:

- (1) diameter (inches) 2"
- (2) total depth (feet) 236
- (3) static water level (feet) 22 ^{below} _{above} top of ground.
- (4) casing _____ (material) _____ (depth) _____ (size) if telescope see back.
- (5) screen 5 _____ 331 _____ (length) _____ (depth to top)
2" _____ Stainless _____ (size) _____ (material)
- (6) pump _____ (HP) _____ (yield gpm) _____ (type power)
- (7) electric log no _____ (yes or no) _____ (organization running log)
- (8) how well bottom plugged BP check

DRILLERS REMARKS: _____

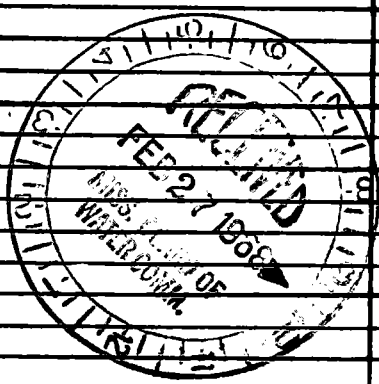

If well telescopes please sketch and show depths.

GROUND LEVEL

10			
	7		
		↑	

SECTION 23

Please indicate well location X.

ADDITIONAL INFORMATION

If more than one screen, show locations of each on sketch.