

48

Jackson
Q 242
3-64

MISSISSIPPI
BOARD OF WATER COMMISSIONERS
416 North State Street
Jackson, Mississippi 39201

WATER WELL DRILLERS LOG

March 12 1964 Cabell Water Supply Jackson
date well completed firm name county well located

LANDOWNER: Smith Bakery
Ware house
Pensacola Miss
(mailing address)

description of formations encountered	from to	
	feet	feet
slush	0	10
sand	10	21
clay	21	42
mud	42	84


WELL LOCATION:
sec 28 T 7 N R 6 E
miles of
(distance) (direction) (nearest town)

WELL PURPOSE: (municipal)
(home, irrigation, municipal, industrial)

WELL COMPLETION DATA:

- (1) diameter (inches) 2
- (2) total depth (feet) 84
- (3) static water level (feet) 26 ^{below} _{above} top of ground.
- (4) casing (material) (depth)
If telescope see back.
(size)
- (5) screen 5 79
(length) (depth to top)
2" plastic
(size) (material)
- (6) pump (HP) (yield gpm)
(type power)
- (7) electric log no
(yes or no)
(organization running log)
- (8) how well bottom plugged BPAVax

DRILLERS REMARKS:

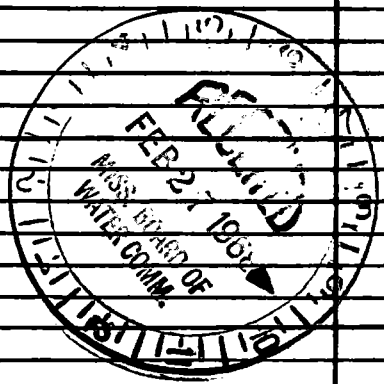

If well telescopes please sketch and show depths.

GROUND LEVEL

			+

SECTION 28

Please indicate well location X.

ADDITIONAL INFORMATION

If more than one screen, show locations of each on sketch.