

49

Jackson
Q 243
4-64

MISSISSIPPI
BOARD OF WATER COMMISSIONERS
416 North State Street
Jackson, Mississippi 39201

WATER WELL DRILLERS LOG

April 1 1964 Billie Water Supply Jackson
date well completed firm name county well located

LANDOWNER: Mrs. Hardy
Esauwpa Miss.
(mailing address)

description of formations encountered	from	to
<u>Soft Blue clay</u>	<u>0</u>	<u>40</u>
<u>Standard gravel</u>	<u>40</u>	<u>75</u>
<u>Clay</u>	<u>75</u>	<u>126</u>
<u>Ground</u>	<u>126</u>	<u>147</u>

WELL LOCATION:
sec. 18 T 7 N R. 5 E
3 miles north of Esauwpa
(distance) (direction) (nearest town)

WELL PURPOSE:
(home, irrigation, municipal, industrial)

WELL COMPLETION DATA:

- (1) diameter (inches) 1 1/4
- (2) total depth (feet) 147
- (3) static water level (feet) 12 ^{below} _{above} top of ground
- (4) casing _____ (material) _____ (depth) _____
(size) If telescope see back.
- (5) screen 5 _____ 142 _____
(length) (depth to top)
1/4 _____ stainless _____
(size) (material)
- (6) pump _____ (HP) _____ (yield gpm)
(type power)
- (7) electric log no (yes or no)
(organization running log)
- (8) how well bottom plugged B.P. Vahr


DRILLERS REMARKS:



If well telescopes please sketch and show depths.

GROUND LEVEL

NW SW

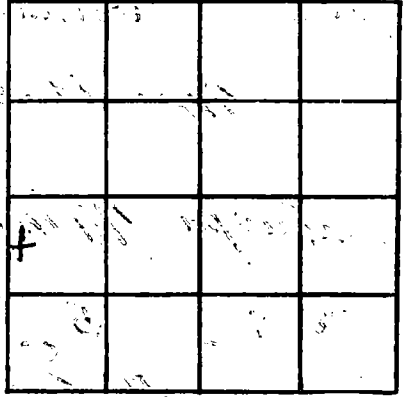

SECTION 18

Please indicate well location X.

ADDITIONAL INFORMATION

If more than one screen, show locations of each on sketch.