

Jackson
Q244
4-64

MISSISSIPPI
BOARD OF WATER COMMISSIONERS
416 North State Street
Jackson, Mississippi 39201

WATER WELL DRILLERS LOG

April 9 1964 Cabille Water Supply Jackson
date well completed firm name county well located

LANDOWNER: Burt Sellar
4th Street, Moss Point
(mailing address)

description of formations encountered	from	to
<u>Sandy Clay</u>	<u>0</u>	<u>10</u>
<u>Blue clay</u>	<u>10</u>	<u>55</u>
<u>sand</u>	<u>55</u>	<u>68</u>

WELL LOCATION:
sec. 30 T. 7 N. R. 5 E.
Moss Point
(distance) (direction) (nearest town)

WELL PURPOSE: irrigation
(home, irrigation, municipal, industrial)


WELL COMPLETION DATA:

- (1) diameter (inches) 2
- (2) total depth (feet) 68
- (3) static water level (feet) 20.4 ^{below} 20.3 ^{above} top of ground
- (4) casing galv
(material) (depth)
 if telescope see back.
(size)
- (5) screen 5 63
(length) (depth to top)
2" Stainless
(size) (material)
- (6) pump
(HP) (yield gpm)

(type power)
- (7) electric log no
(yes or no)

(organization running log)
- (8) how well bottom plugged BP Valve


DRILLERS REMARKS:

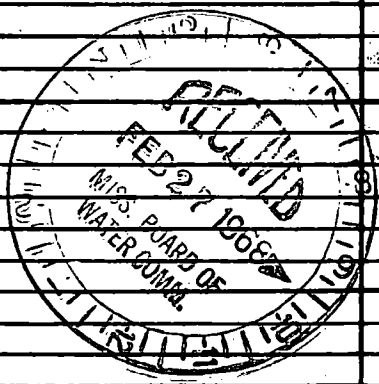

If well telescopes please sketch and show depths.

N.W SE

GROUND LEVEL

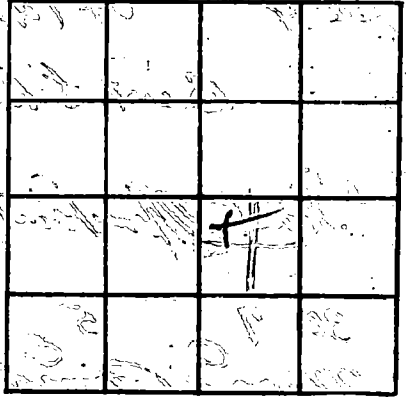

SECTION 30

Please indicate well location X.

ADDITIONAL INFORMATION

If more than one screen, show locations of each on sketch.