

4 R

Jackson  
Q 245  
4-64

MISSISSIPPI  
BOARD OF WATER COMMISSIONERS  
416 North State Street  
Jackson, Mississippi 39201

WATER WELL DRILLERS LOG

April 25 1964 Colville Water Supply Jackson  
date well completed firm name county well located

LANDOWNER: W.W. Adams

description of formations encountered	from	to
<u>yellow &amp; blue clay</u>	<u>0</u>	<u>42</u>
<u>sand</u>	<u>42</u>	<u>82</u>
<u>clay</u>	<u>82</u>	<u>315</u>
<u>sand</u>	<u>315</u>	<u>346</u>

Exotampa, Miss  
(mailing address)

WELL LOCATION:  
sec. 13 T. 7 N. R. 5 E  
4 miles north of Miss Point  
(distance) (direction) (nearest town)

WELL PURPOSE: Home  
(home, irrigation, municipal, industrial)

WELL COMPLETION DATA:

(1) diameter (inches) 1 1/4

(2) total depth (feet) 346

(3) static water level (feet) 10 <sup>below</sup>/<sub>above</sub> top of ground.

(4) casing galv  
(material) (depth)

         if telescope see back.  
(size)

(5) screen 10 336  
(length) (depth to top)

1 1/4 plastic  
(size) (material)

(6) pump                    
(HP) (yield gpm)


          
(type power)

(7) electric log no  
(yes or no)

          
(organization running log)


(8) how well bottom plugged B.P. Vels

DRILLERS REMARKS:         

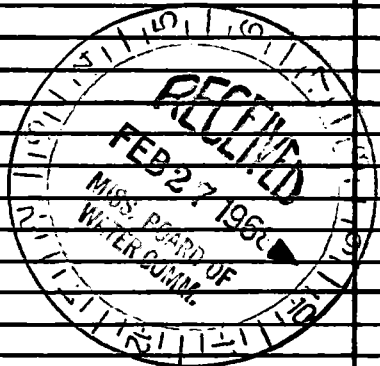

If well telescopes please sketch and show depths.

GROUND LEVEL

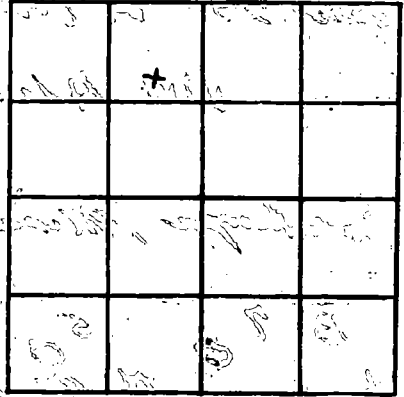

SECTION 13

Please indicate well location X.

ADDITIONAL INFORMATION

A series of horizontal lines for writing additional information. There are approximately 15 lines. Some lines contain faint, illegible handwritten notes.

If more than one screen, show locations of each on sketch.