

59

JACKSON
Q 246
4-64

MISSISSIPPI
BOARD OF WATER COMMISSIONERS
416 North State Street
Jackson, Mississippi 39201

WATER WELL DRILLERS LOG

April 23 1964 Challis Water Supply Jackson
Date well completed firm name county well located


LANDOWNER: John Rawkins
Washington Ave. Pascagoula
(mailing address)

description of formations encountered	from to	
	feet	feet
Slush	0	8
Blue clay	8	48
Sand	48	84

WELL LOCATION:
sec. 13 T. 8 N. R. 5 E.
Pascagoula
(distance) miles (direction) of (nearest town)

WELL PURPOSE: irrigation
(home, irrigation, municipal, industrial)

- WELL COMPLETION DATA:
- (1) diameter (inches) 1 1/2
 - (2) total depth (feet) 84
 - (3) static water level (feet) 20 ^{below} _{above} top of ground.
 - (4) casing galv. (material), _____ (depth)
_____ if telescope see back.
(size)
 - (5) screen 5' 79
(length) (depth to top)
1 1/2 Stander
(size) (material)
 - (6) pump _____ (HP) _____ (yield gpm)
(type power)
 - (7) electric log no (yes or no)
(organization running log)
 - (8) how well bottom plugged BP Valve

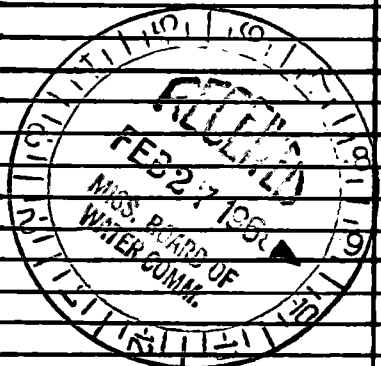


DRILLERS REMARKS:

If well telescopes please sketch and show depths.

GROUND LEVEL

NW NW

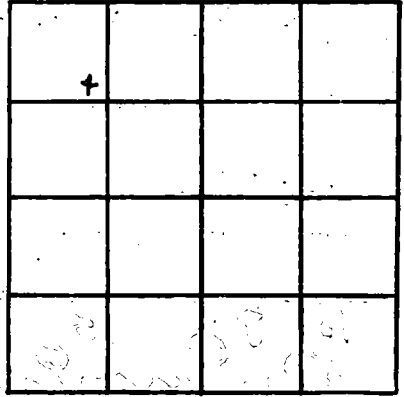

SECTION 18

Please indicate well location X.

ADDITIONAL INFORMATION

If more than one screen, show locations of each on sketch.