




If well telescopes please sketch and show depths.

GROUND LEVEL

NW 3W

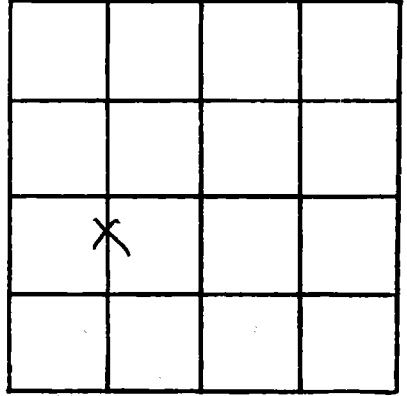

SECTION 23

Please indicate well location X.

ADDITIONAL INFORMATION

If more than one screen, show locations of each on sketch.