

49

Jackson
Q250
6-64

MISSISSIPPI
 BOARD OF WATER COMMISSIONERS
 416 North State Street
 Jackson, Mississippi 39201

WATER WELL DRILLERS LOG

June 9 1964 Mobile Water Supply Jackson
 date well completed firm name county well located


LANDOWNER: Harold Lawrence
Principula, Miss
 (mailing address)

description of formations encountered	from to	
<u>shale</u>	0	10
<u>soft blue clay</u>	10	63
<u>sand</u>	63	72

WELL LOCATION:
 sec 8 T 8 N R 5 E
2 miles east of Principula
 (distance) (direction) (nearest town)

WELL PURPOSE: Home
 (home, irrigation, municipal, industrial)

- WELL COMPLETION DATA:
- (1) diameter (inches) 1 1/4
 - (2) total depth (feet) 92
 - (3) static water level (feet) 16.3 ^{below} _{above} top of ground.
 - (4) casing galv (material), (depth) _____
 _____ if telescope see back.
 (size)
 - (5) screen 5 87
 (length) (depth to top)
1 1/4 Copper gauze
 (size) (material)
 - (6) pump _____ (HP) _____ (yield gpm)
 _____ (type power)
 - (7) electric log no (yes or no)
 _____ (organization running log)
 - (8) how well bottom plugged BP Valve

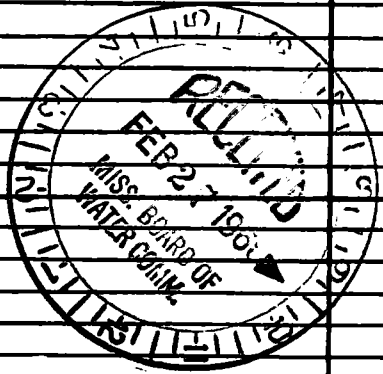

DRILLERS REMARKS:

If well telescopes please sketch and show depths.

GROUND LEVEL

NWSW

SECTION 8

Please indicate well location X.

ADDITIONAL INFORMATION

If more than one screen, show locations of each on sketch.