

Jackson

Q 251

MISSISSIPPI BOARD OF WATER COMMISSIONERS

1-21-65

49

WATER WELL DRILLERS LOG

Date: Jan 21, 1965, Driller: T. C. STORK (Colville County, JACKSON

(Name)

(1) Owner of Land: LARRY NICHOLSON

(Name)

Orange Grove, Miss

(Address)

(2) Location: SE 1/4, SW 1/4, Sec. 22 T3R5W

3 miles east of Osprey (distance) (direction) (Nearest Town)

(3) Topography: flat (Hilly) (Flat) (Level)

(4) Purpose of Well: Dom (Domestic Irrigation Municipal, Industrial, Other)

Description & Color of Materials Sand, Clay, Red Clay, Shell, etc.	Thick- ness Feet	Depth Feet
Clay w/sand streaks	22	22
Sand	38	60
soft clay	6	66
Clay w/sand streaks	22	88
Sand	22	110
Blue clay	66	176
Clay w/sand streaks	8	184
Sand	72	256


Information upon completion of well:

- (1) Diameter 2" inches.
- (2) Total Depth 256 feet.
- (3) Water Level 28 feet below top of ground.
- (4) Cased to 25 ft, Size 2"
- (5) Screen: Size 809a, Length 5 ft.
- (6) Were any formations sealed against pollution?
yes, no.

If YES depth of formation

Why

Drillers Remarks:

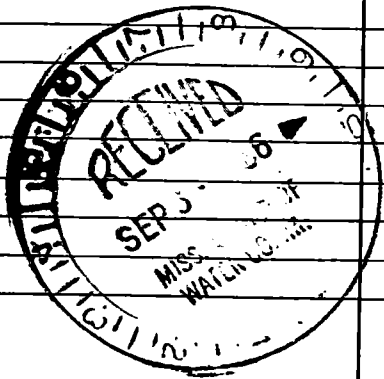

(Use Back Side)

Well No.

