

Jackson

MISSISSIPPI BOARD OF WATER COMMISSIONERS

Q 254

3-22-66  
49

WATER WELL DRILLERS LOG

Date: Mar 22, 1966, Driller: T.C. STORK (Colville) County Jackson  
(Name)

CHURCH OF OUR LORD Jesus  
 (1) Owner of Land: CHRIST of Helena  
 (Name)  
Escatawpa, Miss  
 (Address)

(2) Location NE 1/4, NE 1/4, Sec 6 T 15 R 5 W  
3 miles E of Escatawpa  
 (distance) (direction) (Nearest Town)

(3) Topography: Level  
 (Hilly) (Flat) (Level)

(4) Purpose of Well: Church  
 (Domestic Irrigation  
 Municipal, Industrial, Other)

Description & Color of Materials Sand, Clay, Red Clay, Shell, etc.	Thick- ness Feet	Depth Feet
Clay	10	10
Sand	50	60
Sand & Clay STRKS	20	80
Clay	64	144
Sand	10	154
Clay	40	194
Sand	63	257


Information upon completion of well:

- (1) Diameter 12 inches.
- (2) Total Depth 257 feet.
- (3) Water Level -9 feet below top of ground.
- (4) Cased to 252, Size 2 in
- (5) Screen: Size 2 in 80 mesh, Length 5
- (6) Were any formations sealed against pollution?  
 \_\_\_\_\_ yes,  no.

If YES depth of formation \_\_\_\_\_

Why \_\_\_\_\_

Drillers Remarks: \_\_\_\_\_

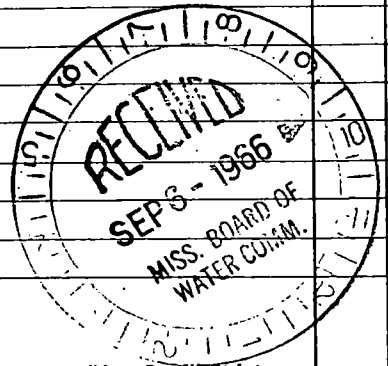

Well No.

Handwritten text, possibly a list or notes, with some legible words like "M. 2. 10" and "M. 2. 11".

Extensive handwritten text, appearing to be a list or a series of notes, covering the lower two-thirds of the page.