

Jackson

Q 255

MISSISSIPPI BOARD OF WATER COMMISSIONERS

3-28-66

WATER WELL DRILLERS LOG

49

Date: Mar 28, 1966, Driller: T.C. STORK (Colville) County Jackson

(Name)

(1) Owner of Land: John W. STORK

(Name)

Orange Grove, Miss.

(Address)

(2) Location: SW 1/4, NE 1/4, Sec. 7 T25R44W

9 miles E of Kreole

(distance)

(direction)

(Nearest Town)

(3) Topography: Level

(Hilly)

(Flat)

(Level)

(4) Purpose of Well: DOM

(Domestic Irrigation  
Municipal, Industrial, Other)

Description & Color of Materials  
Sand, Clay, Red Clay, Shell, etc.

Thick-  
ness  
Feet

Depth  
Feet

CLAY

22 22

SAND

73 95

CLAY

15 110

CLAY & SAND STREAKS

40 150

SAND

55 205

CLAY & SAND STREAKS

10 215

SAND

23 238

Information upon completion of well:

(1) Diameter 1 1/4 inches.

(2) Total Depth 238 feet.

(3) Water Level 6 feet below top of ground.

(4) Cased to 233, Size 1 1/4

(5) Screen: Size 1/4" 1008, Length 5 ft.


(6) Were any formations sealed against pollution?

no  yes,  no.

If YES depth of formation \_\_\_\_\_

Why \_\_\_\_\_

Drillers Remarks: \_\_\_\_\_

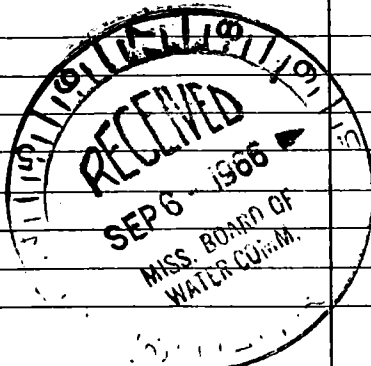

(Use Back Side)

Well No.

