

Q 258

5-3-66

4 R

WATER WELL DRILLERS LOG

Date: May 3, 1966, Driller: J.C. STORR (edville) County: Tazewell
(Name)(1) Owner of Land: BERT LOWLER
(Name)Missile, MD
(Address)(2) Location: NE 1/4, NE 1/4, Sec. 3 T2S R4W5 miles WEST of Edville
(distance) (direction) (Nearest Town)(3) Topography: LEVEL
(Hilly) (Flat) (Level)(4) Purpose of Well: Drill
(Domestic Irrigation
Municipal, Industrial, Other)

Information upon completion of well:

(1) Diameter 1 1/4 inches.(2) Total Depth 175 feet.(3) Water Level 4' 4" feet below top of ground.(4) Cased to 170, Size 1 1/4.(5) Screen: Size 1/4 30 30, Length 5 ft.

(6) Were any formations sealed against pollution?

yes, ✓ no.


If YES depth of formation _____

Why _____

Drillers Remarks: _____

Description & Color of Materials
Sand, Clay, Red Clay, Shell, etc.Thick-
ness
FeetDepth
Feet

Clay & sand streaks	39	22
sand	52	74
clay	27	101
sand	5	106
clay	15	124
sand	51	175

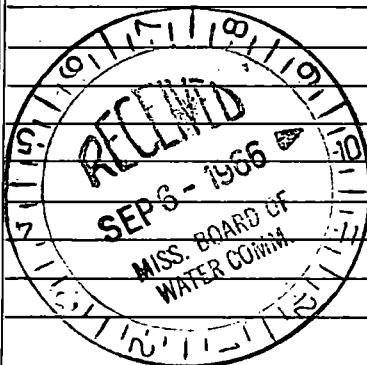

(Use Back Side)

Well No.

