

WATER WELL DRILLERS LOG

Q 261
6-3-66
49

Date: June 3, 1966, Driller: J.C. STORK (Colville) County Jackson

(Name)

(1) Owner of Land: Rev. R.P. PARKER

(Name)

Helena, Miss.

(Address)

(2) Location: NE 1/4, NE 1/4, Sec. 6 T35R5W

3 miles NE of MOSSBURN

(distance)

(direction)

(Nearest Town)

(3) Topography: FLAT

(Hilly)

(Flat)

(Level)

(4) Purpose of Well: DOM

(Domestic Irrigation
Municipal, Industrial, Other)

Description & Color of Materials
Sand, Clay, Red Clay, Shell, etc.

Thick-
ness
Feet

Depth
Feet

CLAY

22

22

SAND

44

66

CLAY

130

196

FINE SAND

14

210

SAND

36

246

Information upon completion of well:

(1) Diameter 2 inches.

(2) Total Depth 246 feet.

(3) Water Level -7 feet below top of ground.

(4) Cased to 241, Size 2 in.

(5) Screen: Size 2 in. 80 ga., Length 5


(6) Were any formations sealed against pollution?

 yes, no.

If YES depth of formation _____

Why _____

Drillers Remarks: _____

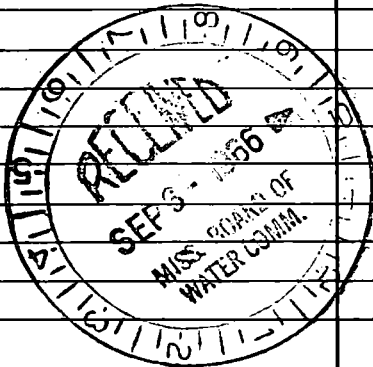

(Use Back Side)

Well No.

