

Q 263
8-66

WATER WELL DRILLERS LOG

Date: Aug 31, 1966, Driller: T. STORK (Colville) County: Jackson
(Name)

(1) Owner of Land: H. L. Bang
(Name)
ORANGE GROVE, Miss
(Address)

(2) Location: NW 1/4, NW 1/4, Sec. 36 T38R5W
10 miles E, off Pascagoula
(distance) (direction) (Nearest Town)

(3) Topography: FLAT
(Hilly) (Flat) (Level)

(4) Purpose of Well: DOM
(Domestic Irrigation
Municipal, Industrial, Other)

Description & Color of Materials Sand, Clay, Red Clay, Shell, etc.	Thick- ness Feet	Depth Feet
<u>Sandy Clay</u>	<u>22</u>	<u>22</u>
<u>SAND</u>	<u>42</u>	<u>64</u>
<u>CLAY</u>	<u>2</u>	<u>66</u>
<u>SAND w/OLY STREAK</u>	<u>22</u>	<u>88</u>
<u>CLAY</u>	<u>4</u>	<u>92</u>
<u>SAND</u>	<u>18</u>	<u>110</u>
<u>GRAVEL</u>	<u>44</u>	<u>154</u>
<u>CLAY</u>	<u>56</u>	<u>210</u>
<u>SAND</u>	<u>23</u>	<u>233</u>

Information upon completion of well:

(1) Diameter 2 inches.

(2) Total Depth 233 feet.

(3) Water Level 29'-8" feet below top of ground.

(4) Cased to 233, Size 2 in.


(5) Screen: Size .008, Length 5 ft.

(6) Were any formations sealed against pollution?
_____ yes, no.

If YES depth of formation _____

Why _____

Drillers Remarks: _____

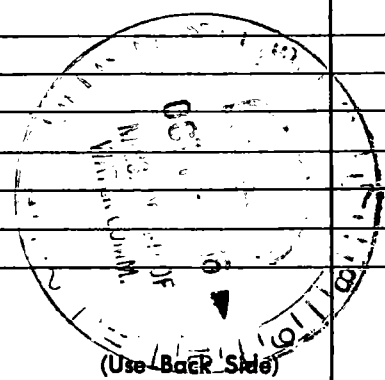

(Use Back Side)

Well No.

