

49

Jackson
Q 264
4-67

MISSISSIPPI
BOARD OF WATER COMMISSIONERS
416 North State Street
Jackson, Mississippi 39201

WATER WELL DRILLERS LOG

April 8 1967 MFB Drilling Co. Jackson
date well completed firm name county well located

LANDOWNER: R. H. Borge
R. R. 1 Pasadena, Miss.

(mailing address)

WELL LOCATION:
sec 22 T 7 S R 5 W
1/2 miles E of Keadle
(distance) (direction) (nearest town)

WELL PURPOSE: Home
(home, irrigation, municipal, industrial)

WELL COMPLETION DATA:
(1) diameter (inches) 2"
(2) total depth (feet) 260
(3) static water level (feet) 23 below top of ground
(4) casing PVC Plastic (material), 25' (depth)

(5) screen 9 ft (length), 25' (depth to top)
2" (size), PVC Filter Pac (material)

(6) pump 1 (HP), 15 (yield gpm)
200 (type power)


(7) electric log No (yes or no)

(organization running log)

(8) how well bottom plugged 2" Cap

description of formations encountered	from	to
Brown Clay	0	15
White Clay	15	20
Soft Grey Clay	20	60
Sand	60	80
Sand & Gravel	80	110
Sand	110	135
Grey Clay	135	185
Shale	185	200
Clay	200	205
Medicine Grey Sand	205	215
Clay	215	217
Sand	217	230
White Clay	230	235
Sand	235	244
Clay	244	246
Sand	246	260
Blue Clay	260	

DRILLERS REMARKS:
Bottom Sand Taking mud rapidly - Well would not back wash. Still developed with air.

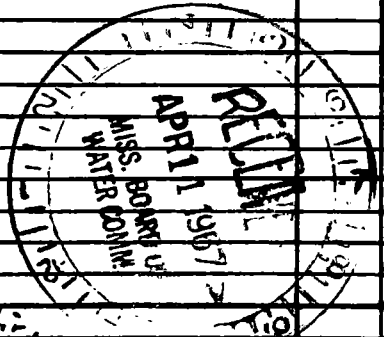


If well telescopes please sketch and show depths.

GROUND LEVEL

base of flow

NW SE

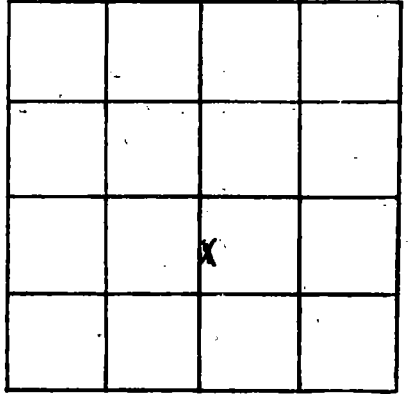

SECTION 22

Please indicate well location X.

ADDITIONAL INFORMATION

If more than one screen, show locations of each on sketch.