

**MISSISSIPPI
BOARD OF WATER COMMISSIONERS
416 North State Street
Jackson, Mississippi 39201**

WATER WELL DRILLERS LOG

Jackson
Q 265
4-67

4-5 date well completed 167 Coast Water Well Service Jackson firm name county well located

LANDOWNER: R. C. Baker
Route 3 Box 387
Pascagoula Miss
(mailing address)

description of formations encountered	from to	
	feet	feet
<u>Red Clay</u>	<u>0</u>	<u>20</u>
<u>Blue Clay</u>	<u>20</u>	<u>84</u>
<u>Blue Clay</u>	<u>84</u>	<u>187</u>
<u>Sand and siltstone</u>	<u>187</u>	<u>210</u>


WELL LOCATION:
sec. 3 T 7 N R 5 E
S W
5 miles NE of Eastman
(distance) (direction) (nearest town)

WELL PURPOSE: Home
(home, irrigation, municipal, industrial)

- WELL COMPLETION DATA:
- (1) diameter (inches) 2
 - (2) total depth (feet) 210
 - (3) static water level (feet) 2 below above top of ground
 - (4) casing Galv. 200
(material) (depth)
2"
(size) if telescope see back.
 - (5) screen 10' 200
(length) (depth to top)
2" Stainless Wrought
(size) (material)
 - (6) pump 1/2 700
(HP) (yield gpm)
Elect
(type power)
 - (7) electric log NO
(yes or no)

(8) how well bottom plugged Back Wash Valve

DRILLERS REMARKS:

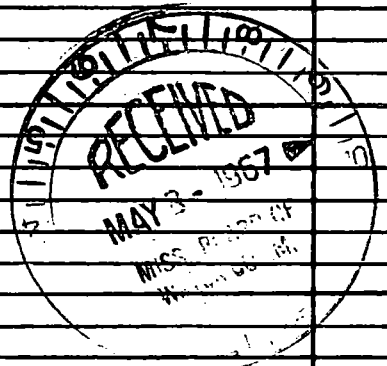

If well telescopes please sketch and show depths.

GROUND LEVEL

NW NW

X			

SECTION _____

Please indicate well location X.

ADDITIONAL INFORMATION

If more than one screen, show locations of each on sketch.